

LAND CORNER RECORDATION CERTIFICATE
 Filing Requirement of Act 74, Mich. P.A. 1970

For corners in

<u>Ontonagon</u> (County)	Located In:	Corner Code #
1. Public Land Survey	T <u>50NR 38W</u>	<u>I-2</u>
	T ___ R ___	_____
	T ___ R ___	_____
	T ___ R ___	_____
2. Property Controlling in Section	S ___ T ___ R ___	_____
	S ___ T ___ R ___	_____
3. Miscellaneous Property in Sec.	S ___ T ___ R ___	_____
	S ___ T ___ R ___	_____
4. Lot No. _____, Recorded Plat _____		
5. Private Claims _____		

**SURVEY &
REMONUMENTATION**

APR 07 1998

SECTION

Register of Deeds Stamp & File Number

I, Joseph C. Domitrovich, in a field survey on October 6, 19 97 do hereby state that under requirements of P.A. 74, Michigan P.A. of 1970, the corner points mentioned in lines 1 and 2 above were in conformance with regulations and rules therefore as required in the current manual of survey instructions of the United States Department of the Interior, Bureau of Land Management or by a decree of a Court of Law and/or that the corner points mentioned in lines 3, 4 and 5 above were in conformance with the rules of the Michigan Board of Land Surveyors or by a Decree of a Court of Law; established, re-established, monumented, recovered, found as expressed below:

NOTE: Not more than 2 corners, all in the same town and range, may be recorded on this certificate.

	A	B	C	D	E	F	G	H	I	J	K	L	M
1													
2	6		5		4		3		2		1		
3													
4	7		8		9		10		11		12		
5													
6	18		17		16		15		14		13		
7													
8	19		20		21		22		23		24		
9													
10	30		29		28		27		26		25		
11													
12	31		32		33		34		35		36		
13													

(I-2) 1/4 Corner Common to Sections 2 & 3, T 50N, R 38W

A. Description of original monument and accessories and/or subsequent restoration:

- 1847 - Sylvester W. Higgins set post
 20" Hemlock S 80° W 16 links
 20" Y. birch N 65° E 16 links
- Undated - Old Mining Map of Algoma and Lake Mines shows this corner but does not indicate what it is. Bearing and distance are shown to NE corner of Section 3: N 00° 18' 30" W 1936.5 feet.
- 1935 - Leo Chantelois, Field Assistant for U.S. Forest Service, as noted on Form 874-9, found a 48" high iron pipe in poor condition. He placed a metal location poster on 10" Hemlock 46 links to the South. He also noted a new road was being constructed.

B. Description of corner evidence found and/or method applied in restoring or reestablishing corner:

Original corner and accessories have ^{been} destroyed by farming and road construction. I found no remains of the 1935 iron pipe or the 10" Hemlock. An East-West road and a North-South fence are the only remaining evidence of the corner. A position at the intersection of the centerline of the road and the North-South fence works well with Mining map bearing and distance to North.

Distances North and South fence work reasonably well with the original GLO. I monumented the fence and centerline intersection as the 1/4 corner.


Research on file with County Remonumentation Representative.

C. Description of monument for corner and accessories established to perpetuate locating the position of the corner:

Corner is a 5/8" x 24" iron with a 3" diameter aluminum cap stamped to read: COUNTY REMONUMENTATION; 1/4; S. 3, S. 2; T.50N, R.38W; 1997; P.S. 37273. I also established a reference monument (R.M.) to the North, a 2" x 30" aluminum pipe with a 3" diameter aluminum cap, stamped to indicate that the 1/4 corner falls to the South 18.58 feet.

10" Balsam	S 46° E	25.70'
7" Oak	S 10° E	29.12'
3" Elm	S 52° W	37.06'
R.M.	N 00° 17' 34" W	18.58'
NE Cor. Section 3	N 00° 27' 14" W	1937.29'
SE Cor. Section 3	S 01° 15' 09" W	2665.04'

PEER GROUP APPROVED
Paul W Applekamp
 COUNTY REPRESENTATIVE

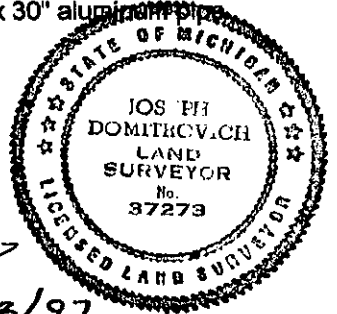

NOTE: Bearings are magnetic. Distances are to nail in side of witness objects unless noted.

Signed by J. C. Domitrovich Date 10/8/97
 Surveyor's Michigan License No. 37273