


**LAND CORNER RECORDATION CERTIFICATE**  
 Filing Requirement of Act 74, Mich. P.A. 1970

For corners in

<u>Ontonagon</u> (County)	Located In:	Corner Code #
1. Public Land Survey	T 50N R 38W	I-3
	T _____ R _____	_____
	T _____ R _____	_____
	T _____ R _____	_____
2. Property Controlling in Section	S _____ T _____ R _____	_____
	S _____ T _____ R _____	_____
3. Miscellaneous Property in Sec.	S _____ T _____ R _____	_____
	S _____ T _____ R _____	_____

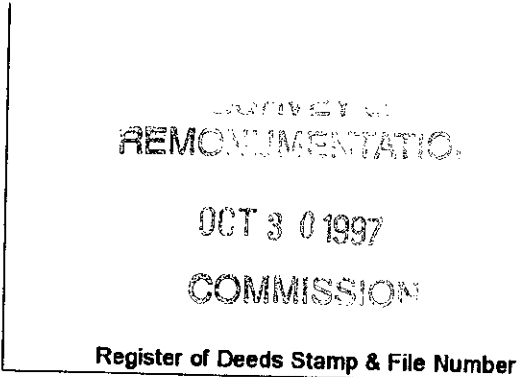

4. Lot No. \_\_\_\_\_, Recorded Plat \_\_\_\_\_  
 5. Private Claims \_\_\_\_\_

I, Joseph C. Domitrovich, in a field survey on August 11, 19 97 do hereby state that under requirements of P.A. 74, Michigan P.A. of 1970, the corner points mentioned in lines 1 and 2 above were in conformance with regulations and rules therefore as required in the current manual of survey instructions of the United States Department of the Interior, Bureau of Land Management or by a decree of a Court of Law and/or that the corner points mentioned in lines 3, 4 and 5 above were in conformance with the rules of the Michigan Board of Land Surveyors or by a Decree of a Court of Law; established, re-established, monumented, recovered, found as expressed below:

NOTE: Not more than 2 corners, all in the same town and range, may be recorded on this certificate.

	A	B	C	D	E	F	G	H	I	J	K	L	M
1													
2	6		5		4		3		2		1		
3									●				
4	7		8		9		10		11		12		
5													
6	18		17		16		15		14		13		
7													
8	19		20		21		22		23		24		
9													
10	30		29		28		27		26		25		
11													
12	31		32		33		34		35		36		
13													

**(I-3) Corner of Sections 2, 3, 10 & 11, T50N, R38W**

A. Description of original monument and accessories and/or subsequent restoration:

- 1847 - Sylvester Higgins, D.S., set post.
  - 10" Sugar S 65° E 27 links
  - 10" Y. Birch S 87° W 14 links (9.24 feet)

B. Description of corner evidence found and/or method applied in restoring or reestablishing corner:

The 10" yellow birch called for in original notes is now a live 25" yellow birch. The face of the blaze and scribing is now rotted away. I re-established the corner position at GLO bearing and distance from the birch. This position falls one foot South of an East-West fence fallen fence and two feet West of a fenceline to the South.

PEER GROUP APPROVED  
*Earl W. Applekamp*  
 COUNTY REPRESENTATIVE 8-13-97

Research on file with County Remonumentation Representative.

C. Description of monument for corner and accessories established to perpetuate locating the position of the corner:

Corner is a 5/8" x 24" rebar with a 3" diameter aluminum cap stamped: COUNTY REMONUMENTATION; 1/4; S. 3, S. 2, S. 10, S. 11; T.50N, R.38W; 1997; P.S. 37273.

**Witnesses:**

4" Hard Maple	North	14.50'	
Steel Sign Post	East	1.64'	(to face)
8" Hard Maple	S 80° E	6.14'	
14" Hemlock	South	12.35'	
25" Yellow Birch	S 87° W	9.90'	(Original B.T. - placed nail in side of tree)
N 1/4 Corner Sec. 11	N 89° 43' 27" E	2647.97'	
W 1/4 Corner Sec. 11	S 00° 01' 58" W	2660.18'	

NOTE: Bearings are magnetic. Distances are to nail in side of witness objects unless noted.

Signed by Joseph C. Domitrovich  
 Surveyor's Michigan License No. 37273

Date 8/13/97

