


**LAND CORNER RECORDATION CERTIFICATE**  
 Filing Requirement of Act 74, Mich. P.A. 1970

For corners in

<u>Ontonagon</u> (County)	Located In:	Corner Code #
1. Public Land Survey	T <u>50N</u> R <u>38W</u>	<u>1-4</u>
	T ___ R ___	_____
	T ___ R ___	_____
	T ___ R ___	_____
2. Property Controlling in Section	S ___ T ___ R ___	_____
	S ___ T ___ R ___	_____
3. Miscellaneous Property in Sec.	S ___ T ___ R ___	_____
	S ___ T ___ R ___	_____

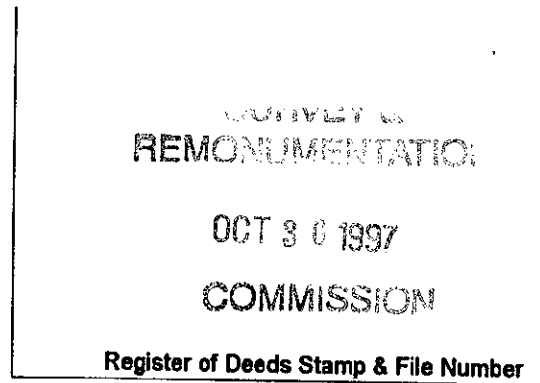

4. Lot No. \_\_\_\_\_, Recorded Plat \_\_\_\_\_  
 5. Private Claims \_\_\_\_\_

I, Joseph C. Domitrovich, in a field survey on September 16, 19 97 do hereby state that under requirements of P.A. 74, Michigan P.A. of 1970, the corner points mentioned in lines 1 and 2 above were in conformance with regulations and rules therefore as required in the current manual of survey instructions of the United States Department of the Interior, Bureau of Land Management or by a decree of a Court of Law and /or that the corner points mentioned in lines 3, 4 and 5 above were in conformance with the rules of the Michigan Board of Land Surveyors or by a Decree of a Court of Law; established, re-established, monumented, recovered, found as expressed below.

NOTE: Not more than 2 corners, all in the same town and range, may be recorded on this certificate.

A	B	C	D	E	F	G	H	I	J	K	L	M
1												
2	6	5	4	3	2	1						
3												
4	7	8	9	10	11	12						
5												
6	18	17	16	15	14	13						
7												
8	19	20	21	22	23	24						
9												
10	30	29	28	27	26	25						
11												
12	31	32	33	34	35	36						
13												

(1-4) 1/4 Corner Common to Sections 10 & 11, T50N, R38W

A. Description of original monument and accessories and/or subsequent restoration:

- 1847 - Sylvester W. Higgins set post.  
 12" Lynn N 72° W 28 links  
 8" Sugar S 80° E 16 links

B. Description of corner evidence found and/or method applied in restoring or reestablishing corner:

The original corner and accessories have been destroyed by road construction. Post Office Road now runs East and South from the corner, and a fence runs to the North and West from it. A single prorated position would fall 25.2 feet West of the North-South fenceline and 3.7 feet South of the East-West fenceline. It also would not work with centerlines to the South and East. I created a position at the intersection of fences and centerlines that I believe better represents the position of the original corner.

Research on file with County Remonumentation Representative.

C. Description of monument for corner and accessories established to perpetuate locating the position of the corner:

- Corner is a 5/8" x 24" iron pin with a 3" diameter aluminum cap stamped to read: COUNTY REMONUMENTATION; 1/4; S. 10, S. 11; T.50N, R.38W; 1997; P.S. 37273.
- |                     |                 |                 |
|---------------------|-----------------|-----------------|
| 5" Oak              | N 55° E         | 31.51'          |
| Power Pole          | S 33° E         | 87.28'          |
| 20" Soft Maple      | S 65° W         | 44.27'          |
| 12" Twin Soft Maple | N 39° W         | 14.79'          |
| Steel Sign Post     | North           | 1.29' (to face) |
| NE Cor. Section 10  | N 00° 01' 58" E | 2660.18'        |
| SE Cor. Section 10  | S 01° 07' 02" W | 2668.14'        |

PEER GROUP APPROVED  
*Earl W. Opeltkamp*  
 COUNTY Ontonagon  
 9-17-97



NOTE: Bearings are magnetic. Distances are to nail in side of witness objects unless noted.

Signed by J. C. Domitrovich  
 Surveyor's Michigan License No. 37273

Date 9/16/97