

LAND CORNER RECORDATION CERTIFICATE
 Filing Requirement of Act 74, Mich. P.A. 1970

For corners in

<u>Ontonagon</u> (County)	Located In:	Corner Code #
1. Public Land Survey	T <u>50NR 38W</u>	<u>1-5</u>
	T <u> R</u>	<u> </u>
	T <u> R</u>	<u> </u>
	T <u> R</u>	<u> </u>
2. Property Controlling in Section	S <u> T</u>	<u> R</u>
	S <u> T</u>	<u> R</u>
3. Miscellaneous Property in Sec.	S <u> T</u>	<u> R</u>
	S <u> T</u>	<u> R</u>

COUNTY OF
REMONUMENTATION

OCT 30 1997


COMMISSION

Register of Deeds Stamp & File Number

4. Lot No. _____, Recorded Plat _____
 5. Private Claims _____

I, Joseph C. Domitrovich, in a field survey on August 6, 19 97 do hereby state that under requirements of P.A. 74, Michigan P.A. of 1970, the corner points mentioned in lines 1 and 2 above were in conformance with regulations and rules therefore as required in the current manual of survey instructions of the United States Department of the Interior, Bureau of Land Management or by a decree of a Court of Law and for that the corner points mentioned in lines 3, 4 and 5 above were in conformance with the rules of the Michigan Board of Land Surveyors or by a Decree of a Court of Law, established, re-established, monumented, recovered, found as expressed below:

NOTE: Not more than 2 corners, all in the same town and range, may be recorded on this certificate.

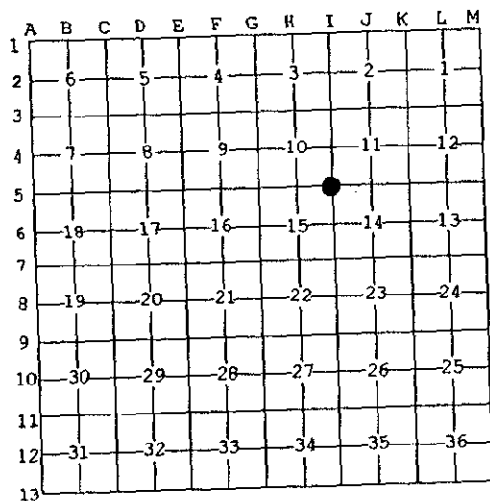

(1-5) Corner of Sections 10, 11, 14 & 15, T50N, R38W

A. Description of original monument and accessories and/or subsequent restoration:

1847 - Sylvester Higgins, D.S., set post.
 10" Sugar N 15° W 9 links
 8" Sugar S 25° E 14 links

1935 - Leo Chantelois, Field Assistant, for Ottawa National Forest Survey, stated, on Form 874-9, that the corner was at a road intersection.

B. Description of corner evidence found and/or method applied in restoring or reestablishing corner:

Original corner and accessories have been destroyed by road construction and farming. The corner now falls in a four-way road intersection. At the intersection of gravel roads North, South, East and field road West, I dug down 24" and found a 3" diameter iron pipe. This pipe falls 19.5 feet SW of theoretical double prorated position. It is, however, the best remaining evidence of the original corner and has been relied on as the section corner for at least 60 years.

I have, therefore, accepted it as the Section Corner.

PEER GROUP APPROVED


Earl W. Applekamp
 COUNTY REPRESENTATIVE 8-13-97

Research on file with County Remonumentation Representative.

C. Description of monument for corner and accessories established to perpetuate locating the position of the corner:

Corner is a 5/8" x 24" rebar driven into a 3" diameter iron pipe, capped with a 3" diameter aluminum cap stamped to read: COUNTY REMONUMENTATION; S. 10, S. 11, S. 15, S. 14; T.50N, R.38W; 1997; P.S. 37273. I also established a reference monument (R.M.) to the Southeast, a 2" x 30" aluminum pipe with a 3" diameter aluminum cap stamped to indicate that the corner is N 46° W 47.78 FT.

7" Elm	S 28° W	67.34'
5" Elm	N 77° W	106.10'
Power pole	N 27° E	67.95'
R.M.	S 46° 21' 40" E	47.78'
S 1/4 Cor. Sec. 11	S 89° 51' 56" E	2651.10'
W 1/4 Cor. Sec. 11	N 01° 07' 02" E	2668.14'

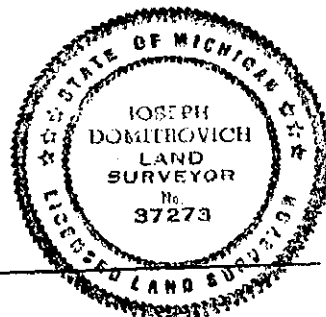

NOTE: Bearings are magnetic. Distances are to nail in side of witness objects unless noted.

Signed by Joseph C. Domitrovich
 Surveyor's Michigan License No. 37273

Date 8/13/97