

LAND CORNER RECORDATION CERTIFICATE
 Filing Requirement of Act 74, Mich. P.A. 1970

For corners in

<u>Ontonagon</u> (County)	Located In:	Corner Code #
1. Public Land Survey	T <u>50N</u> R <u>38W</u>	<u>K-2</u>
	T _____ R _____	_____
	T _____ R _____	_____
	T _____ R _____	_____
2. Property Controlling in Section	S _____ T _____ R _____	_____
	S _____ T _____ R _____	_____
3. Miscellaneous Property in Sec.	S _____ T _____ R _____	_____
	S _____ T _____ R _____	_____

SURVEY &
 REMONUMENTATION

APR 07 1998

SECTION

Register of Deeds Stamp & File Number

4. Lot No. _____, Recorded Plat _____
 5. Private Claims _____

I, Joseph C. Domitrovich, in a field survey on November 5, 19 97 do hereby state that under requirements of P.A. 74, Michigan P.A. of 1970, the corner points mentioned in lines 1 and 2 above were in conformance with regulations and rules therefore as required in the current manual of survey instructions of the United States Department of the Interior, Bureau of Land Management or by a decree of a Court of Law and/or that the corner points mentioned in lines 3, 4 and 5 above were in conformance with the rules of the Michigan Board of Land Surveyors or by a Decree of a Court of Law; established, re-established, monumented, recovered, found as expressed below:

NOTE: Not more than 2 corners, all in the same town and range, may be recorded on this certificate.

(K-2) 1/4 Corner Common to Sections 1 & 2, T 50N, R 38W

A. Description of original monument and accessories and/or subsequent restoration:

- 1847 - Sylvester W. Higgins set wood post
 10" Y. Birch N 84° W 30 links
 12" Lynn S 70° E 41 links
- 1935 - J.T. Paul, Field Assistant for the U.S. Forest Service, stated on Form 874-9, that he found a road intersection and a fence running to the East at the corner.
- 1970 - R.S. Scott Engineering, for Simar Wasas road reconstruction plans, set a P.K. nail at approximate 1/4 corner at the intersection of centerlines North, South, West, and fenceline East.

B. Description of corner evidence found and/or method applied in restoring or reestablishing corner:

Original corner and accessories were not recovered. I found a P.K. nail at the intersection of centerlines of Simar Wasas Road to North and South, Post Office Road to the West, and fenceline to the East. The distance to the South works well with R.S. Scott. Distance North to Closing Corner does not match R.S. Scott, but is closer to GLO. There is a substantial deflection in the Section line here at the 1/4 corner, but it is not inconsistent with other work done by Higgins in this township.

Distances North and South:

Closing Corner (NE Cor. Section 2)	N 02° 12' 12" W	1942.43' (meas.)	1949.2 (Scott)	1940.4 (GLO)
SE Cor. Section 2	S 01° 15' 48" E	2675.42' (meas.)	2675.0 (Scott)	2640 (GLO)

I accepted the P.K. nail at intersection as the best remaining evidence of the original corner.

Research on file with County Remonumentation Representative.


C. Description of monument for corner and accessories established to perpetuate locating the position of the corner:

Corner is a 5/8" rebar set below asphalt surface, capped with a 3" diameter aluminum cap stamped to read: COUNTY REMONUMENTATION; T.50N, R.38W; 1/4; S. 2, S. 1; 1997; P.S. 37273. I also established reference monument (R.M.) to the Southwest, a 2" x 30" aluminum pipe with a 3" dia. aluminum cap stamped to indicate that the 1/4 corner is N 40° E 43.85'.

Witnesses:

Power Pole	N 50° W	47.58'
Anchor Pole	N 35° E	39.24'
6" White Pine	S 35° E	45.38'
R.M.	S 39° 42' 18" W	43.85'

BEER GROUP APPROVED
Paul W. Applebaum
 COUNTY REMONUMENTATION 11-11-97

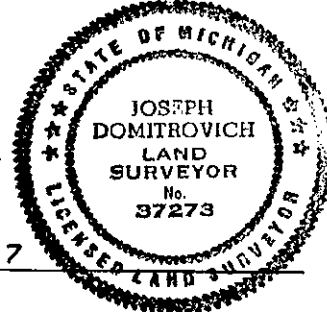

NOTE: Bearings are magnetic. Distances are to nail in side of witness objects unless noted.

Signed by J. C. Domitrovich Date 11/10/97

Surveyor's Michigan License No. 37273