


JUDITH D. ROEHM 07/18/97  
 Ontonagon County 11:30  
 LC 4/313 JJT Fee: 9.00  
 Page 1 of 1


**LAND CORNER RECORDATION CERTIFICATE**  
 Filing Requirement of Act 74, Mich. P.A. 1970

For corners in

<u>Ontonagon</u> (County)	Located In:	Corner Code #
1. Public Land Survey	T 50 R 38	K-4
	T ___ R ___	___
	T ___ R ___	___
	T ___ R ___	___
2. Property Controlling in Section	S ___ T ___ R ___	___
	S ___ T ___ R ___	___
3. Miscellaneous Property in Sec.	S ___ T ___ R ___	___
	S ___ T ___ R ___	___

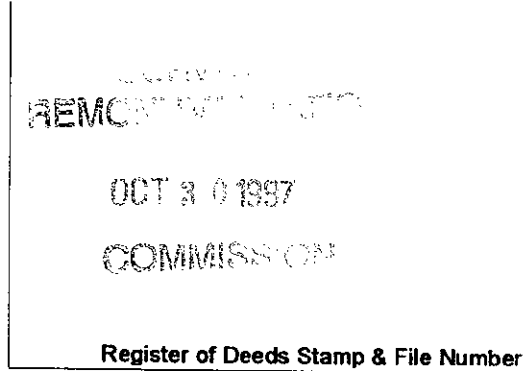

4. Lot No. \_\_\_\_\_, Recorded Plat \_\_\_\_\_  
 5. Private Claims \_\_\_\_\_

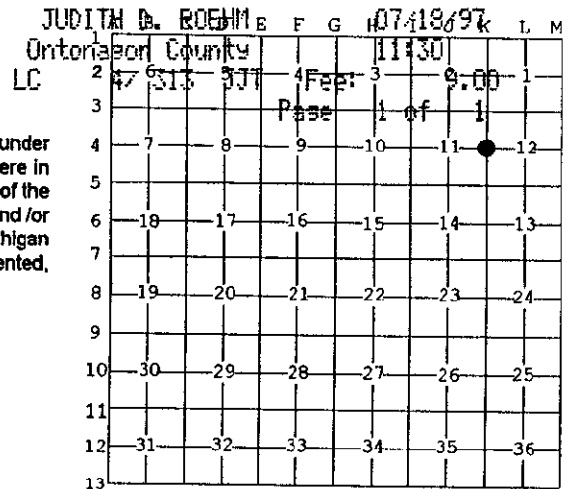

I, Joseph C. Domitrovich, in a field survey on July 14, 19 97 do hereby state that under requirements of P.A. 74, Michigan P.A. of 1970, the corner points mentioned in lines 1 and 2 above were in conformance with regulations and rules therefore as required in the current manual of survey instructions of the United States Department of the Interior, Bureau of Land Management or by a decree of a Court of Law and/or that the corner points mentioned in lines 3, 4 and 5 above were in conformance with the rules of the Michigan Board of Land Surveyors or by a Decree of a Court of Law; established, re-established, monumented, recovered, found as expressed below:

NOTE: Not more than 2 corners, all in the same town and range, may be recorded on this certificate.

**(K-4) 1/4 Corner Common to Sections 11 & 12, T50N, R38W**

A. Description of original monument and accessories and/or subsequent restoration:

1847 - Sylvester W. Higgins, D.S., set post  
 8" Balsam N 70° W 35 links  
 8" Balsam S 68° E 30 links

1970 - R.S. Scott Engineering, in road reconstruction plans on file at Ontonagon County Road Commission office, set a P.K. nail at approximate 1/4 Corner position in centerline of Simar-Wasas Road on the extension of a fence line to the West.  
 Fence post N 70° E 89.90'  
 Fence post West 75.23'

B. Description of corner evidence found and/or method applied in restoring or reestablishing corner:

The original corner and accessories have been destroyed by road construction and extensive farming.

R.S. Scott Corner and accessories have also been destroyed by road construction and a deep cut through a hillside. I found remains of fence to the West and used it to re-establish R.S. Scott corner position in the centerline of Simar-Wasas Road.

Distances from this position to existing stream crossings work reasonably well with GLO distances. Distances North and South to Section corners work reasonably well with R.S. Scott distances.

I accepted this position as the 1/4 Corner position and have monumented it as such.

Research on file with County Remonumentation Representative.

C. Description of monument for corner and accessories established to perpetuate locating the position of the corner:

Corner is a 5/8" iron pin with a 3" diameter aluminum cap stamped to read: COUNTY REMONUMENTATION; T.50N, R.38W; 1/4; S. 11, S. 12; 1997; P.S. 37273. I also established a reference monument (R.M.) to the West, a 2" x 30" aluminum pipe with a 3" diameter aluminum cap stamped to indicate that the corner is East 24.24'.

Witnesses:	*Note: Due to steep banks, distances are EDM reduced to horizontal.	
8" Poplar	N 24° W	137.11'
Power Pole	N 29° E	148.72'
Power Pole (# A-50)	S 50° E	124.33'
R.M.	N 89° 35' 28" W	24.24'
NE Cor. Sec. 11	N 00° 19' 30" W	2648.06' (meas.) 2649.40' (R.S. Scott)
SE Cor. Sec. 11	S 00° 43' 32" W	2666.85' (meas.) 2665.90' (R.S. Scott)

NOTE: Bearings are magnetic. Distances are to nail in side of witness objects unless noted.

Signed by J. C. Domitrovich  
 Surveyor's Michigan License No. 37273

Date 7/14/97

**PEER GROUP APPROVED**  
*Earl W. Applekamp*  
 COUNTY REPRESENTATIVE  
 7-15-97

