

LAND CORNER RECORDATION CERTIFICATE
 Filing Requirement of Act 74, Mich. P.A. 1970

For corners in

<u>Ontonagon</u> (County)	Located In:	Corner Code #
1. Public Land Survey	T 50N R 39W	C-3
	T ___ R ___	_____
	T ___ R ___	_____
	T ___ R ___	_____
2. Property Controlling in Section	S ___ T ___ R ___	_____
	S ___ T ___ R ___	_____
3. Miscellaneous Property in Sec.	S ___ T ___ R ___	_____
	S ___ T ___ R ___	_____

SURVEY &
 REMONUMENTATION

APR 07 1998

SECTION

Register of Deeds Stamp & File Number

4. Lot No. _____, Recorded Plat _____
 5. Private Claims _____

I, Joseph C. Domitrovich, in a field survey on December 16, 19 97 do hereby state that under requirements of P.A. 74, Michigan P.A. of 1970, the corner points mentioned in lines 1 and 2 above were in conformance with regulations and rules therefore as required in the current manual of survey instructions of the United States Department of the Interior, Bureau of Land Management or by a decree of a Court of Law and /or that the corner points mentioned in lines 3, 4 and 5 above were in conformance with the rules of the Michigan Board of Land Surveyors or by a Decree of a Court of Law; established, re-established, monumented, recovered, found as expressed below:

NOTE: Not more than 2 corners, all in the same town and range, may be recorded on this certificate.

(C-2) Corner of Sections 5, 6, 7 & 8, T50N, R39W

A. Description of original monument and accessories and/or subsequent restoration:

1847 - Sylvester W. Higgins set post.
 20" Hemlock S 40° W 8 links (5.28 feet)
 12" Hemlock N 15° E 32 links (21.12 feet)

B. Description of corner evidence found and/or method applied in restoring or reestablishing corner:

I recovered the remains of the 20" Hemlock called for in the original notes. It is now a 48" rotten stump with remains of grown over GLO blaze. I re-established the corner at record bearing and distance from the Hemlock stump. The 12" Hemlock from original notes was not recovered. This position works well with natural feature calls to the East, West, and South.


Distances to corners North and East:
 S 1/4 Corner Section 5 N 89° 26' 52" E 2610.26'
 W 1/4 Corner Section 5 N 00° 12' 16" E 2667.05'

Research on file with County Remonumentation Representative.

C. Description of monument for corner and accessories established to perpetuate locating the position of the corner:
 Corner is a 3/4" x 36" aluminum rod with a 3" diameter aluminum cap stamped to read: COUNTY REMONUMENTATION; T.50N, R.39W; S. 5, S. 6, S. 7, S. 8; 1997; P.S. 37273.

Witnesses:
 4" Soft Maple S 18° W 35.66'
 9" Hard Maple N 57° W 4.12'
 4" Twin Hard Maple N 30° E 8.47'
 5" Twin Hard Maple S 40° E 6.45'
 Steel Sign Post South 0.90' (to face)

DEED GROUP APPROVED
Earl W. Applekamp
 COUNTY REPRESENTATIVE
 12-19-97

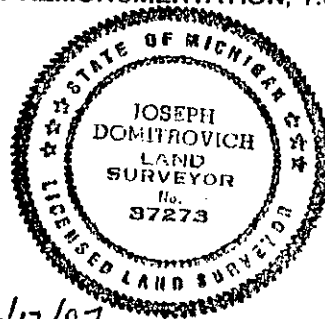

NOTE: Bearings are magnetic. Distances are to nail in side of witness objects unless noted.

Signed by J. C. Domitrovich Date 12/17/97
 Surveyor's Michigan License No. 37273