

JUDITH D. ROEHL 07/19/97  
 Ontonagon County 11:29  
 4/311 JJT Feet 9.00  
 Page 1 of 1

**LAND CORNER RECORDATION CERTIFICATE**  
 Filing Requirement of Act 74, Mich. P.A. 1970

For corners in

<u>Ontonagon</u> (County)	Located in:	Corner Code #
1. Public Land Survey	T <u>50</u> R <u>39</u>	<u>D-1</u>
	T <u>   </u> R <u>   </u>	<u>   </u>
	T <u>   </u> R <u>   </u>	<u>   </u>
	T <u>   </u> R <u>   </u>	<u>   </u>
2. Property Controlling in Section	S <u>   </u> T <u>   </u> R <u>   </u>	<u>   </u>
	S <u>   </u> T <u>   </u> R <u>   </u>	<u>   </u>
3. Miscellaneous Property in Sec.	S <u>   </u> T <u>   </u> R <u>   </u>	<u>   </u>
	S <u>   </u> T <u>   </u> R <u>   </u>	<u>   </u>

COUNTY OF  
**REMONUMENTATION**  
 OCT 30 1997  
 COMMISSION

Register of Deeds Stamp & File Number

4. Lot No. \_\_\_\_\_, Recorded Plat \_\_\_\_\_  
 5. Private Claims \_\_\_\_\_

	A	B	C	D	E	F	G	H	I	J	K	L	M
1				●									
2	6			5		4		3		2		1	
3													
4	7			8		9		10		11		12	
5													
6	18			17		16		15		14		13	
7													
8	19			20		21		22		23		24	
9													
10	30			29		28		27		26		25	
11													
12	31			32		33		34		35		36	
13													

I, Joseph C. Domitrovich, in a field survey on July 9, 1997 do hereby state that under requirements of P.A. 74, Michigan P.A. of 1970, the corner points mentioned in lines 1 and 2 above were in conformance with regulations and rules therefore as required in the current manual of survey instructions of the United States Department of the Interior, Bureau of Land Management or by a decree of a Court of Law and/or that the corner points mentioned in lines 3, 4 and 5 above were in conformance with the rules of the Michigan Board of Land Surveyors or by a Decree of a Court of Law; established, re-established, monumented, recovered, found as expressed below.

NOTE: Not more than 2 corners, all in the same town and range, may be recorded on this certificate.

**(D-1) N1/4 Corner of Section 5, T50N, R39W**

A. Description of original monument and accessories and/or subsequent restoration:

This corner was not set in the original survey.

Closing corners (on the 5th Correction Line) to East and West were set by Sylvester W. Higgins in 1847.

B. Description of corner evidence found and/or method applied in restoring or reestablishing corner:

In the area of the corner, there were existing fences and paint lines that were run in by landowners from the Closing Corner to the East. I did not accept these fairly recent indications of occupation and established the corner midway between Closing Corners and on line between the South 1/4 and SE Corner of the Section 35, T51N, R39W (standard Corners).

Research on file with County Remonumentation Representative.


C. Description of monument for corner and accessories established to perpetuate locating the position of the corner:

Corner is a 5/8" x 48" iron pin with a 3" diameter aluminum cap stamped to read: COUNTY REMONUMENTATION; 1/4; S. 5; C.C.; 1997; P.S. 37273. Corner falls 17' North of an East-West fence.

Witnesses:

12" Basswood	N 11° E	21.72'
4" Ash	S 05° E	25.19'
6" Hard Maple	S 72° W	7.66'
10" Soft Maple	N 70° W	18.03'
Steel Sign Post	North	0.8'

**PEER GROUP APPROVED**  
*Carl W. Appala*  
 COUNTY REPRESENTATIVE 7-15-97

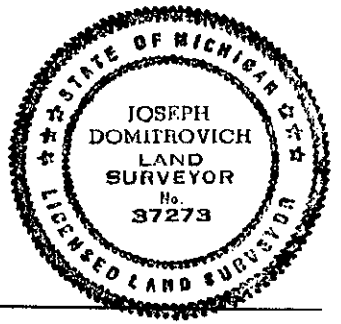

NOTE: Bearings are magnetic. Distances are to nail in side of witness objects unless noted.

Signed by Joseph C. Domitrovich Date 7/15/97

Surveyor's Michigan License No. 37273