

LAND CORNER RECORDATION CERTIFICATE
 Filing Requirement of Act 74, Mich. P.A. 1970

For corners in

<u>Ontonagon</u> (County)	Located In:	Corner Code #
1. Public Land Survey	T <u>50N</u> R <u>39W</u>	<u>D-3</u>
	T _____ R _____	_____
	T _____ R _____	_____
	T _____ R _____	_____
2. Property Controlling in Section	S _____ T _____ R _____	_____
	S _____ T _____ R _____	_____
3. Miscellaneous Property in Sec.	S _____ T _____ R _____	_____
	S _____ T _____ R _____	_____

**SURVEY &
 REMONUMENTATION**


APR 07 1998

SECTION

Register of Deeds Stamp & File Number

4. Lot No. _____, Recorded Plat _____
 5. Private Claims _____

I, Joseph C. Domitrovich, in a field survey on December 16, 19 97 do hereby state that under requirements of P.A. 74, Michigan P.A. of 1970, the corner points mentioned in lines 1 and 2 above were in conformance with regulations and rules therefore as required in the current manual of survey instructions of the United States Department of the Interior, Bureau of Land Management or by a decree of a Court of Law and /or that the corner points mentioned in lines 3, 4 and 5 above were in conformance with the rules of the Michigan Board of Land Surveyors or by a Decree of a Court of Law; established, re-established, monumented, recovered, found as expressed below:

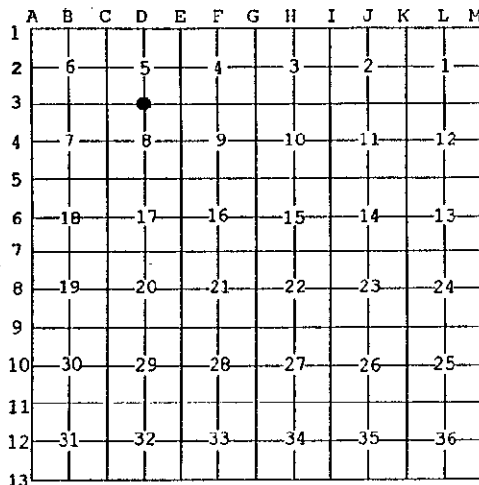

NOTE: Not more than 2 corners, all in the same town and range, may be recorded on this certificate.

(D-3) 1/4 Corner Common to Sections 5 & 8, T50N, R39W

A. Description of original monument and accessories and/or subsequent restoration:

1847 - Sylvester W. Higgins set post.
 15" Lynn S 30° E 18 links
 8" Lynn N 40° W 28 links

B. Description of corner evidence found and/or method applied in restoring or reestablishing corner:

Original corner and accessories were not recovered. I found no evidence whatsoever of the corner. I re-established the corner by single proportionate measurement. This corner works reasonably well with other corners in the Section.

SW Corner Section 5 S 89° 26' 52" W 2610.26'
 SE Corner Section 5 N 89° 26' 52" E 2610.26'

Research on file with County Remonumentation Representative.


C. Description of monument for corner and accessories established to perpetuate locating the position of the corner:

Corner is a 3/4" x 36" aluminum rod with a 3" diameter aluminum cap stamped to read: COUNTY REMONUMENTATION, T. 50N, R. 39W; 1/4; S. 5, S. 8; 1997; P.S. 37273.

Witnesses:

3" Soft Maple	S 60° W	3.73'
14" Spruce	N 03° E	6.14'
6" Ash	S 10° E	22.64'
Steel Sign Post	S 65° E	1.31' (to face)

PEER GROUP APPROVAL
Earl W. Goble
 COUNTY REPRESENTATIVE
 12-19-97

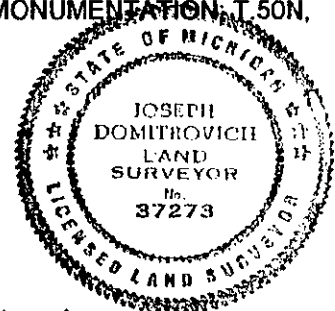

NOTE: Bearings are magnetic. Distances are to nail in side of witness objects unless noted.

Signed by J. C. Domitrovich Date 12/17/97
 Surveyor's Michigan License No. 37273