SURVEY & REMONUMENTATION

DEC 1 6 1996

COMMISSION

JUDITH D. ROEHM 06/14/96
Ontonagon County 10:28
LC 4/ 83 JEM Fee: 9.00
Page 1 of 1

LAND CORNER RECORDATION CERTIFICATE

Filing Requirement of Act 74, Mich. P.A. 1970

For corners in Ontonagon (County) Located In: Corner Code #

1. Public Land Survey		T 50N	R 39W	F-1
		T ____	R ____	
		T ____	R ____	
		T ____	R ____	
2. Property Controlling	S ____	T ____	R ____	
in Section	S ____	T ____	R ____	
3. Miscellaneous	S ____	T ____	R ____	
Property in Section	S ____	T ____	R ____	

Register of Deeds Stamp & File Number

4. Lot No. _____, Recorded Plat _____
5. Private Claims _____

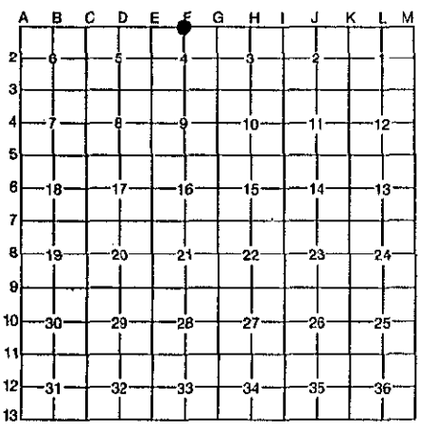

I, Joseph C. Domitrovich, in a field survey on June 5, 19 96, do hereby certify that under requirements of P.A. 74, Michigan P.A. of 1970, the corner points mentioned in lines 1 and 2 above were in conformance with regulations and rules therefore as required in the current manual of survey instructions of the United States Department of the Interior, Bureau of Land Management or by a decree of a Court of Law and/or that the corner points mentioned in lines 3, 4 and 5 above were in conformance with the rules of the Michigan Board of Professional Surveyors or by a Decree of a Court of Law; established, re-established, monumented, re-monumented, recovered, found as expressed below:

NOTE: Not more than 4 corners, all in the same town and range, may be recorded on this certificate.

A. Description of original monument and accessories and/or subsequent restoration:

(F-1) North 1/4 Corner Section 4, T50N, R39W

Corner was not set in original survey but was established midway between closing corners to the east and west and on the township line.

B. Description of corner evidence found and/or method applied in restoring or reestablishing corner:

Established corner position midway between closing corners to the east and west and on the township line between the south 1/4 corner Section 36, T51N, R39W and the township corner to the east.

PEER GROUP APPROVED
Earl W Applekamp
COUNTY REPRESENTATIVE 6-06-96

Research on file with County Remonumentation Representative.

C. Description of monument for corner and accessories established to perpetuate locating the position of the corner:

Corner is a 2" x 30" aluminum pipe with a 3" diameter aluminum cap stamped to read: T.50N., R.39W.; 1/4 S. 4; 1996; P.S. 37273. Corner falls 2' south of edge of logging trail.

Witnesses:

12" Hard Maple	South	11.90'
11" Oak	S 42° W	15.59'
8" Hard Maple	N 80° W	25.62'
1" Iron Pipe	N 48° W	29.02'
Steel Sign Post	S 48° E	0.80'

STATE OF MICHIGAN
JOSEPH DOMITROVICH
LAND SURVEYOR
No. 37273
LICENSED LAND SURVEYOR

NOTE: Bearings are magnetic. Distances are to nail in side of witness objects unless noted.

Signed by Joseph C. Domitrovich Date 6/5/96

Surveyor's Michigan License No. 37273

FORM APPROVED BY MICHIGAN STATE BOARD OF PROFESSIONAL SURVEYORS, JAN. 26, 1971
REVISED MAY 14, 1975
REVISED JAN., 1983