

SURVEY & REMONUMENTATION

APR 29 1996

COMMISSION

JUDITH D. ROEHM
 Ontonagon County
 LC 4/ 18 JEM Fee: 9.00
 12/28/95
 12:10
 Page 1 of 1

LAND CORNER RECORDATION CERTIFICATE
Filing Requirement of Act 74, Mich. P.A. 1970

For corners in
Ontonagon
 (County)

Located In: Corner Code #

- | | | |
|------------------------------------|---------------------------|-----------|
| 1. Public Land Survey | T <u>50N</u> R <u>39W</u> | <u>F5</u> |
| | T _____ R _____ | _____ |
| | T _____ R _____ | _____ |
| | T _____ R _____ | _____ |
| 2. Property Controlling in Section | S _____ T _____ R _____ | _____ |
| | S _____ T _____ R _____ | _____ |
| 3. Miscellaneous Property in Sec. | S _____ T _____ R _____ | _____ |
| | S _____ T _____ R _____ | _____ |

Register of Deeds Stamp & File Number

4. Lot No. _____, Recorded Plat _____
 5. Private Claims _____

I, Dennis R. Destrampe, in a field survey on October 4, 1995, do hereby certify that under requirements of P.A. 74, Michigan P.A. of 1970, the corner points mentioned in lines 1 and 2 above were in conformance with regulations and rules therefore as required in the current manual of survey instructions of the United States Department of the Interior, Bureau of Land Management or by a decree of a Court of Law and/or that the corner points mentioned in lines 3, 4 and 5 above were in conformance with the rules of the Michigan Board of Land Surveyors or by a Decree of a Court of Law; established, re-established, monumented, re-monumented, recovered, found as expressed below:

NOTE: Not more than 4 corners, all in the same town and range, may be recorded on this certificate.


A	B	C	D	E	F	G	H	I	J	K	L	M
2	6	5	4	3	2	1						
3												
4	7	8	9	10	11	12						
5												
6	18	17	16	15	14	13						
7												
8	19	20	21	22	23	24						
9												
10	30	29	28	27	26	25						
11												
12	31	32	33	34	35	36						
13												

A. Description of original monument and accessories and/or subsequent restoration:

Post
 Sugar 14 N2E 14
 do 8 S5W 22
 Corner shown on survey of section by Robert A. Mick, R.L.S. 16936, dated October 3, 1983, recorded in Survey Book 1, Page 68, Ontonagon County Register's Office.

B. Description of corner evidence found and/or method applied in restoring or reestablishing corner:

No evidence found of original corner or accessories. Found a 1 1/2" iron pipe as described in Mick survey. Traversed perimeter of section, agreed within reason with Mick survey dimensions. Accepted corner as found. Research data on file with the county representative.

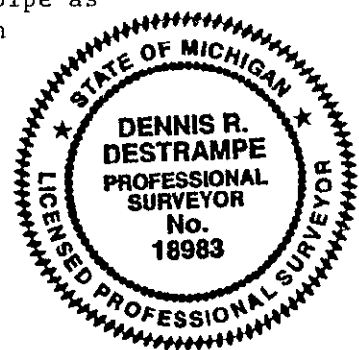

PEER GROUP APPROVED

Paul W. Applikans 12-14-95
 COUNTY REPRESENTATIVE

C. Description of monument for corner and accessories established to perpetuate locating the position of the corner:

Replaced 1 1/2" iron pipe with a standard 2"x30" aluminum pipe monument with a 3 1/4" aluminum cap 0.5' above ground. Cap stamped:

COUNTY REMONUMENTATION

The following witnesses were established:

- | | |
|---------------------------|--|
| E face 8" Elm | N04°W 66.25' (Nail & tag "UPEA 18983") |
| W face 6" Apple | S09°E 48.92' (Nail & tag "UPEA 18983") |
| W face 6" Hawthorne | S33°W 46.02' (Nail & tag "UPEA 18983") |
| S face 8" Fence Post West | 7.37' (Nail & tag "UPEA 18983") |
| 6' Steel Sign Post | S15°E 1.62' |

T50N R39W
 S9
 1/4" —●—
 S16
 1995
 PS 18983

All bearing trees blazed and scribed NBT

Signed by Dennis R. Destrampe Date 11/1/95
 Surveyor's Michigan License No. 18983