

**SURVEY & REMONUMENTATION**

DEC 1 6 1996

**COMMISSION**

**LAND CORNER RECORDATION CERTIFICATE**  
**Filing Requirement of Act 74, Mich. P.A. 1970**

JUDITH D. ROEHM  
 Ontonagon County  
 LC 4/ 81 JEM Feet 9.00  
 06/14/96  
 10:27  
 Page 1 of 1

For corners in Ontonagon (County) Located In: \_\_\_\_\_ Corner Code # \_\_\_\_\_

1. Public Land Survey	T <u>50N</u> R <u>39W</u>	G-1
	T _____ R _____	_____
	T _____ R _____	_____
	T _____ R _____	_____
2. Property Controlling in Section	S _____ T _____ R _____	_____
	S _____ T _____ R _____	_____
3. Miscellaneous Property in Section	S _____ T _____ R _____	_____
	S _____ T _____ R _____	_____

4. Lot No. \_\_\_\_\_, Recorded Plat \_\_\_\_\_

5. Private Claims \_\_\_\_\_

Register of Deeds Stamp & File Number

A	B	C	D	E	F	G	H	I	J	K	L	M
2	6	5	4	3	2	1						
3												
4	7	8	9	10	11	12						
5												
6	18	17	16	15	14	13						
7												
8	19	20	21	22	23	24						
9												
10	30	29	28	27	26	25						
11												
12	31	32	33	34	35	36						
13												

I, Joseph C. Domitrovich, in a field survey on June 5, 1996, do hereby certify that under requirements of P.A. 74, Michigan P.A. of 1970, the corner points mentioned in lines 1 and 2 above were in conformance with regulations and rules therefore as required in the current manual of survey instructions of the United States Department of the Interior, Bureau of Land Management or by a decree of a Court of Law and/or that the corner points mentioned in lines 3, 4 and 5 above were in conformance with the rules of the Michigan Board of Professional Surveyors or by a Decree of a Court of Law; established, re-established, monumented, re-monumented, recovered, found as expressed below:

**NOTE: Not more than 4 corners, all in the same town and range, may be recorded on this certificate.**

**A. Description of original monument and accessories and/or subsequent restoration:**

(G-1) Closing Corner Sections 3 & 4, T50N, R39W

1847 - S.W. Higgins intersected correction line 8 chains 53 links west of 1/4 post in Section 31, T51N, R38W and set post  
 8" Sugar S 27° W 19 Links  
 8" Sugar S 80° E 47 Links

**B. Description of corner evidence found and/or method applied in restoring or reestablishing corner:**

John Myllylahti, a local resident for over 70 years showed me a gnarled, hollow sugar maple over 30" in diameter that years ago had a Forest Service Location Poster on it. I found the badly rusted metal tag at the base of this tree. Using this tree as the 8" sugar S 80° E 47 links (31.02') from the original corner I restored the corner position. This matches the record bearing and distance to the 8" sugar S 27° W 19 links (12.54') Now a 30" + stump and windfall.

**PEER GROUP APPROVED**  
*Earl W. Applekamp*  
 COUNTY REPRESENTATIVE 6-06-96


Research on file with County Remonumentation Representative.

**C. Description of monument for corner and accessories established to perpetuate locating the position of the corner:**

Corner is a 2" x 30" aluminum pipe with a 3" diameter aluminum cap stamped to read: T.50N., R39W.: S.4, S.3: C.C.: 1996: P.S. 37273. Remains of a very old blazed line extends south from corner.

**Witnesses:**

34" Hard Maple	N 83° E	31.53'
6" Yellow Birch	S 60° E	25.15'
7" Yellow Birch	N 70° W	27.75'
12" Hard Maple	N 33° W	13.23'
Steel Sign Post	North	0.85'

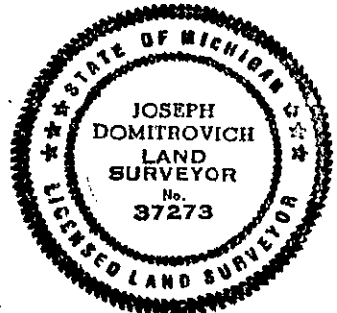

**NOTE: Bearings are magnetic. Distances are to nail in side of witness objects unless noted.**

Signed by Joseph C. Domitrovich Date 6/5/96

Surveyor's Michigan License No. 37273