

**SURVEY &
REMONUMENTATION**

APR 29 1996

COMMISSION

JUDITH D. ROEHM 12/28/95
 Ontonagon County 12:09
 LC 4/ 16 JEM Fee: 9.00
 Page 1 of 1

LAND CORNER RECORDATION CERTIFICATE
Filing Requirement of Act 74, Mich. P.A. 1970

For corners in

Ontonagon (County)	Located In:	Corner Code ##
1. Public Land Survey	T <u>50N</u> R <u>39W</u>	<u>G3</u>
	T _____ R _____	_____
	T _____ R _____	_____
	T _____ R _____	_____
2. Property Controlling in Section	S _____ T _____ R _____	_____
	S _____ T _____ R _____	_____
3. Miscellaneous Property in Sec.	S _____ T _____ R _____	_____
	S _____ T _____ R _____	_____
4. Lot No. _____, Recorded Plat _____		
5. Private Claims _____		

Register of Deeds Stamp & File Number

	A	B	C	D	E	F	G	H	I	J	K	L	M
2	6	5	4	3	2	1							
3							⊕						
4	7	8	9	10	11	12							
5													
6	18	17	16	15	14	13							
7													
8	19	20	21	22	23	24							
9													
10	30	29	28	27	26	25							
11													
12	31	32	33	34	35	36							
13													

I, Dennis R. Destrampe, in a field survey on October 4, 1995, do hereby certify that under requirements of P.A. 74, Michigan P.A. of 1970, the corner points mentioned in lines 1 and 2 above were in conformance with regulations and rules therefore as required in the current manual of survey instructions of the United States Department of the Interior, Bureau of Land Management or by a decree of a Court of Law and/or that the corner points mentioned in lines 3, 4 and 5 above were in conformance with the rules of the Michigan Board of Land Surveyors or by a Decree of a Court of Law; established, re-established, monumented, re-monumented, recovered, found as expressed below:


NOTE: Not more than 4 corners, all in the same town and range, may be recorded on this certificate.

A. Description of original monument and accessories and/or subsequent restoration:

Post Sugar 12 N60°E 33 do 9 S30°W 22	Corner shown on survey of section by Robert A. Mick, R.L.S. 16936, dated October 3, 1983, recorded in Survey Book 1, Page 68, Ontonagon County Register's Office. Corner recorded May 13, 1985 in Liber 2, Page 230, by Richard L. Drahn, R.L.S. 21564.
--	---

B. Description of corner evidence found and/or method applied in restoring or reestablishing corner:

No evidence found of original corner or accessories. Found corner as recorded in Liber 2, Page 230, U.S.F.S. monument and bearing trees in place. Accepted corner as found. Research data on file with the county representative.

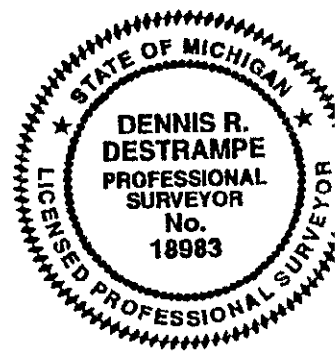

PEER GROUP APPROVED

Paul W. [Signature] 12-14-95
 COUNTY REPRESENTATIVE

C. Description of monument for corner and accessories established to perpetuate locating the position of the corner:

Existing 2" aluminum pipe monument with 3 1/2" aluminum cap 8" above ground left in place.
 Cap stamped:

Used existing U.S.F.S Bearing Trees as follows:

E face 5" Northern Red Oak N14°W 26.38' (Nail & tag "UPEA 18983")	T50N R39W
W face 6" Northern Red Oak S20°W 27.81' (Nail & tag "UPEA 18983")	S.4 S.3
N face 10" Northern Red Oak S83°W 11.25' (Nail & tag "UPEA 18983")	S.9 S.10
6' Steel Sign Post N54°E 3.54' (U.S.F.S. Witness Sign)	

Established the following bearing tree blazed and scribed NBT 1984
 E face 12" White Ash N38°W 17.21' (Nail & tag "UPEA 18983")
 RLS 21564

Signed by Dennis R. Destrampe Date 11/1/95

Surveyor's Michigan License No. 18983