

SURVEY & REMONUMENTATION

APR 29 1995

COMMISSION

JUDITH D. ROEHN 12/28/95
 Ontonagon County 12:08
 LC 4/ 14 JEM Feet: 9.00
 Page 1 of 1

LAND CORNER RECORDATION CERTIFICATE
Filing Requirement of Act 74, Mich. P.A. 1970

For corners in
Ontonagon
 (County)

1. Public Land Survey	Located In:	Corner Code #
	T 50N R 39W	G4
	T ___ R ___	_____
	T ___ R ___	_____
	T ___ R ___	_____
2. Property Controlling in Section	S ___ T ___ R ___	_____
	S ___ T ___ R ___	_____
3. Miscellaneous Property in Sec.	S ___ T ___ R ___	_____
	S ___ T ___ R ___	_____

4. Lot No. _____, Recorded Plat _____
 5. Private Claims _____

Register of Deeds Stamp & File Number

A	B	C	D	E	F	G	H	I	J	K	L	M
2	6	5	4	3	2	1						
3												
4	7	8	9	10	11	12						
5												
6	18	17	16	15	14	13						
7												
8	19	20	21	22	23	24						
9												
10	30	29	28	27	26	25						
11												
12	31	32	33	34	35	36						
13												

I, Dennis R. Destrampe, in a field survey on October 4, 1995, do hereby certify that under requirements of P.A. 74, Michigan P.A. of 1970, the corner points mentioned in lines 1 and 2 above were in conformance with regulations and rules therefore as required in the current manual of survey instructions of the United States Department of the Interior, Bureau of Land Management or by a decree of a Court of Law and/or that the corner points mentioned in lines 3, 4 and 5 above were in conformance with the rules of the Michigan Board of Land Surveyors or by a Decree of a Court of Law; established, re-established, monumented, re-monumented, recovered, found as expressed below:


NOTE: Not more than 4 corners, all in the same town and range, may be recorded on this certificate.

A. Description of original monument and accessories and/or subsequent restoration:

Post	Corner shown on survey of section by Robert A. Mick, R.L.S. 16936, dated October 3, 1983, recorded in Survey Book 1, Page 68, Ontonagon County Register's Office.
Sugar 12 N61W 30	
do 10 S60E 30	

B. Description of corner evidence found and/or method applied in restoring or reestablishing corner:

No evidence found of original corner or accessories. Found a 1" drill steel set in concrete 8" below ground. Mick survey called for a pipe, but in our perimeter traverse of the section we agreed with the Mick survey distance to the southeast corner. (This $E\frac{1}{2}$ corner is also the northeast corner of the Plat of Rosendale.) The property owner stated this had been used as the corner. Due to the property owners use of the land, no bearing trees of the Mick survey were left. Accepted corner as found. Research data on file with the county representative.

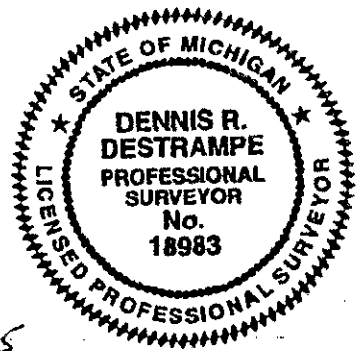

PEER GROUP APPROVED

Carl W. Applekamp 12-14-95
 COUNTY REPRESENTATIVE

C. Description of monument for corner and accessories established to perpetuate locating the position of the corner:

Left existing drill steel in place, raised point 8" to surface with $\frac{1}{2}$ " galvanized pipe and adaptor driven onto 1" drill steel, with a $3\frac{1}{2}$ " aluminum cap. Cap stamped:

The following witnesses were established:

S face 6" Twin Apple N60°W 54.45' (Nail & tag "UPEA 18983")	T50N R39W
N face 6" Apple N50°W 33.96' (Nail & tag "UPEA 18983")	1/4
S face 6" Apple N18°W 72.69' (Nail & tag "UPEA 18983")	S9 ● S10
S face 10" Sugar Maple N12°W 108.80' (Nail & tag "UPEA 18983")	1995
6' Steel Sign Post N89°E 1.81'	PS 18983

Signed by Dennis R. Destrampe
 Surveyor's Michigan License No. 18983

Date 11/2/95