

SURVEY & REMONUMENTATION

APR 29 1996

COMMISSION

JUDITH D. ROEHM
Ontonagon County
LC 4/ 13 JEM Feet: 9.00
12/28/95
12:08
Page 1 of 1

LAND CORNER RECORDATION CERTIFICATE Filing Requirement of Act 74, Mich. P.A. 1970

For corners in

Ontonagon <small>(County)</small>	Located In:	Corner Code #
1. Public Land Survey	T <u>50N</u> R <u>39W</u>	<u>G5</u>
	T _____ R _____	_____
	T _____ R _____	_____
	T _____ R _____	_____
2. Property Controlling in Section	S _____ T _____ R _____	_____
	S _____ T _____ R _____	_____
3. Miscellaneous Property in Sec.	S _____ T _____ R _____	_____
	S _____ T _____ R _____	_____
4. Lot No. _____, Recorded Plat _____		
5. Private Claims _____		

Register of Deeds Stamp & File Number

I, Dennis R. Destrampe, in a field survey on October 4, 19 95, do hereby certify that under requirements of P.A. 74, Michigan P.A. of 1970, the corner points mentioned in lines 1 and 2 above were in conformance with regulations and rules therefore as required in the current manual of survey instructions of the United States Department of the Interior, Bureau of Land Management or by a decree of a Court of Law and/or that the corner points mentioned in lines 3, 4 and 5 above were in conformance with the rules of the Michigan Board of Land Surveyors or by a Decree of a Court of Law; established, re-established, monumented, re-monumented, recovered, found as expressed below:

NOTE: Not more than 4 corners, all in the same town and range, may be recorded on this certificate.

A. Description of original monument and accessories and/or subsequent restoration:


Post Sugar 8 N59W 40 do 12 S50E 7	Corner shown on survey of section by Robert A. Mick, R.L.S. 16936, dated October 3, 1983, recorded in Survey Book 1, Page 68, Ontonagon County Register's Office.
---	---

B. Description of corner evidence found and/or method applied in restoring or reestablishing corner:

No evidence found of original corner or accessories. Found 1/2" iron pin at the location of 1" iron pin called for in Mick survey, with witnesses as described by Mick. Traversed perimeter of section, agreed within reason with Mick survey dimensions. (This corner also being a plat corner of the Addition to the Plat of Rosendale.) Earl W. Applekamp, P.S. 17610, stated to me that he found the 1" iron pin gone, and had set the 1/2" iron pin from the Mick witnesses. Accepted corner as found. Research data on file with the county representative.

PEER GROUP APPROVED

Earl W. Applekamp 12-14-95
COUNTY REPRESENTATIVE

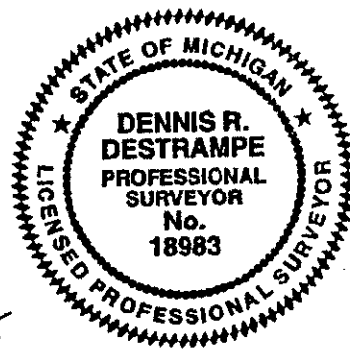

C. Description of monument for corner and accessories established to perpetuate locating the position of the corner:

Replaced 1/2" iron pin with a standard 2"x30" aluminum pipe monument with a 3/4" aluminum cap flush with ground. Cap stamped:

COUNTY REMONUMENTATION

The following witnesses were established:

N face Power Pole S45°E 76.85' (Nail & tag "UPEA 18983")
 N face Power Pole S61°W 122.52' (Nail & tag "UPEA 18983")
 SE Corner of House N69°W 57.28'
 SW Corner of Garage N04°E 25.18'

T50N R39W

S9	S10
S16	S15

1995

PS 18983

Due to corner falling in private residence lawn, monument was set flush with ground. Witness Post & Sign was not set. Homeowner is aware of corner,

Signed by Dennis R. Destrampe Date 11/2/95

Surveyor's Michigan License No. 18983