

LAND CORNER RECORDATION CERTIFICATE  
 Filing Requirement of Act 74, Mich. P.A. 1970

For corners in

ONTONAGON  
 (County)

Located in:

Corner Code #

1. Public Land Survey

T50N R41W A-5 ✓  
 T50N R42W M-5

2. Property Controlling in Section

T R  
 T R

3. Miscellaneous Property in Sec.


S T R  
 S T R  
 S T R

4. Lot No. \_\_\_\_\_, Recorded Plat \_\_\_\_\_  
 5. Private Claims \_\_\_\_\_

Section Corner common to Sections 7 & 18, T50N R41W & Sections 12 & 13, T50N R42W.

I, Earl W. Applekamp, in a field survey on Dec. 06, 1999 do hereby state that under requirements of P.A. 74, Michigan P.A. of 1970, the corner points mentioned in lines 1 and 2 above were in conformance with regulations and rules therefore as required in the current manual of survey instructions of the United States Department of the Interior, Bureau of Land Management or by a decree of a Court of Law and/or that the corner points mentioned in lines 3, 4 and 5 above were in conformance with the rules of the Michigan Board of Land Surveyors or by a Decree of a Court of Law, established, re-established, monumented, recovered, found as expressed below:

NOTE: Not more than 2 corners, all in the same town and range, may be recorded on this certificate.

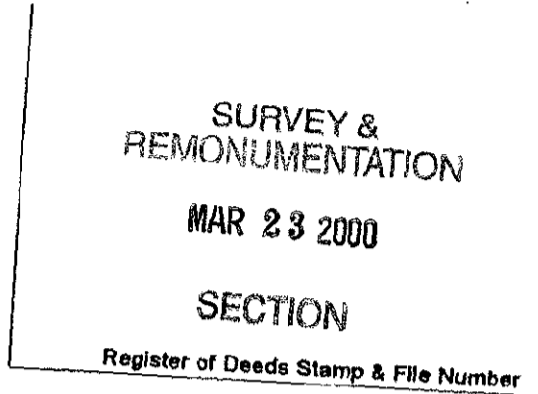

A	B	C	D	E	F	G	H	I	J	K	L	M
1												
2	6	5	4	3	2	1						
3												
4	7	8	9	10	11	12						
5												
6	18	17	16	15	14	13						
7												
8	19	20	21	22	23	24						
9												
10	30	29	28	27	26	25						
11												
12	31	32	33	34	35	36						
13												

A. Description of original monument and accessories and/or subsequent restoration:  
 Original Corner established by William A. Burt, U.S. Deputy Surveyor, August 19, 1847. Set Ironwood Post. ORIGINAL BEARING TREES: Hemlock 20", S40°E, 21 Links (13.86'), Hemlock 30", N20°W 26 Links (17.16'). During construction of the L.P. Walsh Road, corner was re-stored. The drawings prepared by R.S. Scott Engineering Co. Inc., of Alpena, Michigan, dated July 29, 1967, identify the corner at Station 185+04.75 and 42 feet North of the centerline of the L.P. Walsh Road. This information was not recorded with the Register of Deeds.

B. Description of corner evidence found and/or method applied in restoring or reestablishing corner:

Based on the information above, I found a 3/4"x24" pipe with a 2" brass cap flush with the ground. I accepted this as being the only logical position for the corner. I replaced the 3/4" x24" pipe w/cap and set a monument described in "C" below.

Research on file with the Ontonagon County Remonumentation Program Representative.

C. Description of monument for corner and accessories established to perpetuate locating the position of the corner:

At the corner position I set a 2 1/2"x30" split base aluminum pipe with 3" cap flush with the ground. Cap is stamped to read: County Remonumentation T50N, R41W, R42W, S7, S18, S12, S13, 1999, P.S. 17610. I established five bearing objects.

Nail in N. side P. Pole N74°W 118.07' - Centerline L.P. Walsh Road 41.74  
 Nail in NE side P. Pole N39°W 98.07' - 6' Steel Sign Post North 0.7'  
 Nail in N. side P. Pole N86°E 383.55'

PEER GROUP APPROVED  
Earl W. Applekamp  
 COUNTY REPRESENTATIVE  
 12-20-99



Signed by Earl W. Applekamp  
 Surveyor's Michigan License No. 17610

Date December 11, 1999