

LAND CORNER RECORDATION CERTIFICATE
 Filing Requirement of Act 74, Mich. P.A. 1970

For corners in

<u>ONTONAGON</u> (County)	Located in:	Corner Code #
1. Public Land Survey	T 50N R 42W	C-3
	T ___ R ___	_____
	T ___ R ___	_____
	T ___ R ___	_____
2. Property Controlling in Section	S ___ T ___ R ___	_____
	S ___ T ___ R ___	_____
3. Miscellaneous Property in Sec.	S ___ T ___ R ___	_____
	S ___ T ___ R ___	_____

SURVEY & REMONUMENTATION

MAR 23 2000

SECTION


Register of Deeds Stamp & File Number

4. Lot No. _____, Recorded Plat _____
 5. Private Claims _____

Section Corner common to Sections 5, 6, 7 & 8, T50N R42W.

I, Earl W. Applekamp, in a field survey on May 20, 1999 do hereby state that under requirements of P.A. 74, Michigan P.A. of 1970, the corner points mentioned in lines 1 and 2 above were in conformance with regulations and rules therefore as required in the current manual of survey instructions of the United States Department of the Interior, Bureau of Land Management or by a decree of a Court of Law and /or that the corner points mentioned in lines 3, 4 and 5 above were in conformance with the rules of the Michigan Board of Land Surveyors or by a Decree of a Court of Law; established, re-established, monumented, recovered, found as expressed below:

NOTE: Not more than 2 corners, all in the same town and range, may be recorded on this certificate.

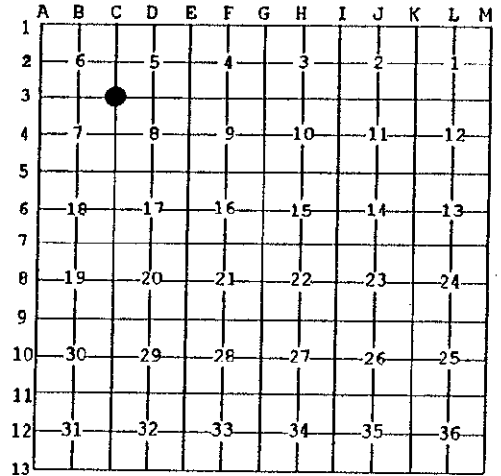

A. Description of original monument and accessories and/or subsequent restoration:

Original corner established by Austin Burt, U.S. Deputy Surveyor, June 19, 1848. Set Yellow Birch Post.

ORIGINAL BEARING TREES:

12" Sugar S65°W 9.24 feet
 14" Maple N46°E 5.94 feet

PEER GROUP APPROVED
Earl W. Applekamp
 COUNTY REPRESENTATIVE
 6-9-99

B. Description of corner evidence found and/or method applied in restoring or reestablishing corner:

No original evidence was found. A 3/4" pipe was found near the calculated position. There was a blue line running South from the pipe. There was a cut line running West from the same position. A descend hill call East is in conformance with G.L.O. I accepted the pipe as the most logical position for the corner.

Research on file with the Ontonagon County Remonumentation Program Representative.

C. Description of monument for corner and accessories established to perpetuate locating the position of the corner:

At the corner position I set a 2 1/2"x30" split base aluminum pipe over the 3/4" pipe. The 2 1/2" pipe has a 3" cap stamped to read: County Remonumentation, S5, S6, S7, S8, 1999, P.S. 17610. I established three bearing trees and a reference object.

Nail in 11" Hemlock S64°W 16.99' - Nail in 10" Hemlock S05°E 27.72'
 Nail in 9 1/2" Hemlock N55°E 65.20' - 6' Steel Sign Post North 0.94'

Copper Range Co. Coordinates N 29973.69 feet E 24734.11 feet



Signed by Earl W. Applekamp
 Surveyor's Michigan License No. 17610

Date May 26, 1999