

LAND CORNER RECORDATION CERTIFICATE
Filing Requirement of Act 74, Mich. P.A. 1970

For corners in

SURVEY & REMONUMENTATION

MAR 23 2000

SECTION

Register of Deeds Stamp & File Number

ONTONAGON (County)

Located In:

Corner Code #


- 1. Public Land Survey T50N R42W C-5
2. Property Controlling in Section S T R
3. Miscellaneous Property in Sec. S T R

4. Lot No. , Recorded Plat
5. Private Claims

Section Corner common to Sections 7, 8, 17, & 18, T50N R42W.

I, Earl W. Applekamp, in a field survey on May 18, 1999 do hereby state that under requirements of P.A. 74, Michigan P.A. of 1970, the corner points mentioned in lines 1 and 2 above were in conformance with regulations and rules therefore as required in the current manual of survey instructions of the United States Department of the Interior, Bureau of Land Management or by a decree of a Court of Law and /or that the corner points mentioned in lines 3, 4 and 5 above were in conformance with the rules of the Michigan Board of Land Surveyors or by a Decree of a Court of Law; established, re-established, monumented, recovered, found as expressed below:

NOTE: Not more than 2 corners, all in the same town and range, may be recorded on this certificate.

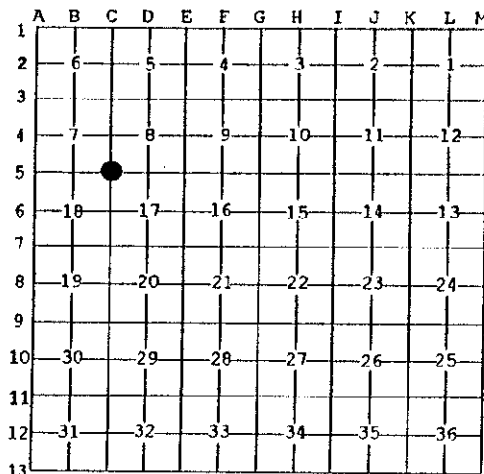

A. Description of original monument and accessories and/or subsequent restoration:

Original corner established by Austin Burt, U.S. Deputy Surveyor, June 19, 1848. Set Spruce Post.

ORIGINAL BEARING TREES:

- 10" Hemlock S46°E 19.14 feet
10" Maple S44°W 18.48 feet

PEER GROUP APPROVED
Earl W. Applekamp
COUNTY SURVEYOR
6-9-99

B. Description of corner evidence found and/or method applied in restoring or reestablishing corner:

No original evidence was found. At the apparent corner position I found a 4" squared cedar post standing. This was in conformance with the calculated position. A forester had run a blue paint line North from this post for the purpose of logging West in Section 7. There was a yellow bearing tree sign, almost completely rusted away on a tree 25 feet Northwest of the cedar post. There were two blazed cedar trees facing post. I accepted the cedar post as the only logical position for the corner.

Research on file with the Ontonagon County Remonumentation Program Representative.

C. Description of monument for corner and accessories established to perpetuate locating the position of the corner:

At the corner position I set a 3/4"x48" aluminum rod with a 3" cap stamped to read: County Remonumentation, T50N R42W, S7, S8, S17, S18, 1999, P.S. 17610. I established three bearing trees and a reference object.

- Nail in 5 1/2" Maple S44°W 32.27' - Nail in 13" Cedar S65°E 23.25'
Nail in 6" Cedar N08°E 15.42' - 6' Steel Sign Post West 0.97'

Copper Range Company Coordinates N 24705.67 feet E 24750.04 feet



Signed by Earl W. Applekamp
Surveyor's Michigan License No. 17610

Date May 26, 1999