


LAND CORNER RECORDATION CERTIFICATE  
 Filing Requirement of Act 74, Mich. P.A. 1970

For corners in

<u>ONTONAGON</u> (County)	Located in:	Corner Code #
1. Public Land Survey	T50N R42W	D-1
	T___ R___	_____
	T___ R___	_____
	T___ R___	_____
2. Property Controlling in Section	S___ T___ R___	_____
	S___ T___ R___	_____
3. Miscellaneous Property in Sec.	S___ T___ R___	_____
	S___ T___ R___	_____

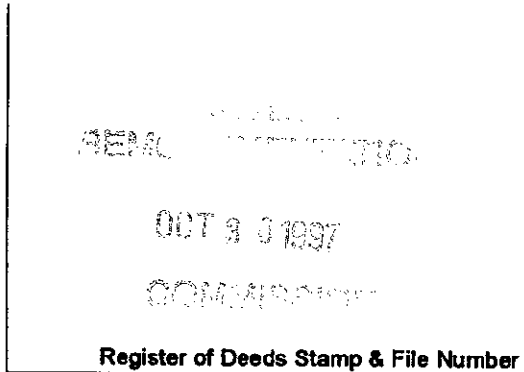

4. Lot No. \_\_\_\_\_, Recorded Plat \_\_\_\_\_  
 5. Private Claims \_\_\_\_\_

N $\frac{1}{4}$  Corner, Section 5, T50N R42W, on 5th Correction Line.

I, Earl W. Applekamp, in a field survey on August 6, 1997 do hereby state that under requirements of P.A. 74, Michigan P.A. of 1970, the corner points mentioned in lines 1 and 2 above were in conformance with regulations and rules therefore as required in the current manual of survey instructions of the United States Department of the Interior, Bureau of Land Management or by a decree of a Court of Law and/or that the corner points mentioned in lines 3, 4 and 5 above were in conformance with the rules of the Michigan Board of Land Surveyors or by a Decree of a Court of Law, established, re-established, monumented, recovered, found as expressed below:

NOTE: Not more than 2 corners, all in the same town and range, may be recorded on this certificate.

A	B	C	D	E	F	G	H	I	J	K	L	M
1			●									
2	6		5	4		3		2		1		
3												
4	7		8	9		10		11		12		
5												
6	18		17	16		15		14		13		
7												
8	19		20	21		22		23		24		
9												
10	30		29	28		27		26		25		
11												
12	31		32	33		34		35		36		
13												

A. Description of original monument and accessories and/or subsequent restoration:

Original corner not established on original survey.

PEER GROUP APPROVED  
*Earl W. Applekamp*  
 COUNTY REPRESENTATIVE 9-17-97

B. Description of corner evidence found and/or method applied in restoring or reestablishing corner:

This corner is identified in the Plat of Evergreen Acres which was prepared by Ostlings Surveys in 1970. I located the corner position from bearings and distances to plat monuments given on the Plat. At the position I found a squared Cedar Post laying on the ground but no monument. I re-established the corner at the calls given on the Plat and monumented as described below.

Research on file with the Ontonagon County Remonumentation Program Representative.

C. Description of monument for corner and accessories established to perpetuate locating the position of the corner:

At the corner position I set a 2 $\frac{1}{2}$ "x30" split base aluminum pipe with a 3" cap stamped to read: County Remonumentation, T50N R42W,  $\frac{1}{4}$ , S5, 1997, P.S. 17610. I established three bearing trees and two reference objects.

- 10" Maple S22°W 38.37' - Plat Mon. on Sec. Line S89°-53'-41"E 113.65'
- 11" Maple N25°W 15.72' - Steel Sign Post North 1.54'
- 5" Maple S88°E 27.76' -



Signed by Earl W. Applekamp  
 Surveyor's Michigan License No. 17610

Date September 15, 1997