

**LAND CORNER RECORDATION CERTIFICATE**  
 Filing Requirement of Act 74, Mich. P.A. 1970

For corners in

ONTONAGON (County)	Located In:	Corner Code #
1. Public Land Survey	T 50NR 42W	D-5
	T R	
	T R	
	T R	
2. Property Controlling In Section	S T R	
	S T R	
3. Miscellaneous Property in Sec.	S T R	
	S T R	

**SURVEY &  
 REMONUMENTATION**

MAR 23 2000

SECTION


Register of Deeds Stamp & File Number

4. Lot No. \_\_\_\_\_, Recorded Plat \_\_\_\_\_  
 5. Private Claims \_\_\_\_\_

1/4 Corner common to Sections 8 & 17, T50N R42W.

I, Earl W. Applekamp, in a field survey on May 21, 1999 do hereby state that under requirements of P.A. 74, Michigan P.A. of 1970, the corner points mentioned in lines 1 and 2 above were in conformance with regulations and rules therefore as required in the current manual of survey instructions of the United States Department of the Interior, Bureau of Land Management or by a decree of a Court of Law and for that the corner points mentioned in lines 3, 4 and 5 above were in conformance with the rules of the Michigan Board of Land Surveyors or by a Decree of a Court of Law; established, re-established, monumented, recovered, found as expressed below:

NOTE: Not more than 2 corners, all in the same town and range, may be recorded on this certificate.

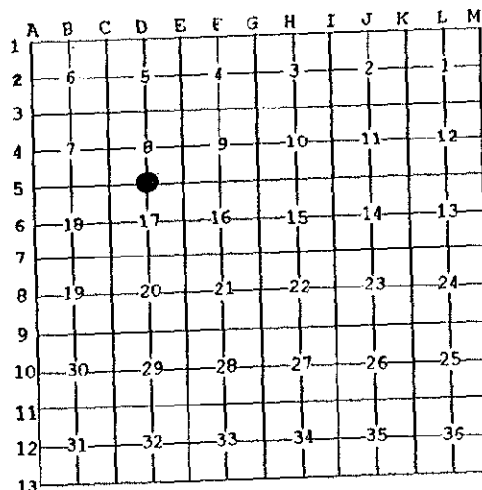

A. Description of original monument and accessories and/or subsequent restoration:

Original corner established by Austin Burt, U.S. Deputy Surveyor, June 19, 1848.  
 Set Maple Post.

ORIGINAL BEARING TREES:

22" Hemlock	S61°E	17.16 feet
14" Y. Birch	N23°E	18.48 feet

B. Description of corner evidence found and/or method applied in restoring or reestablishing corner:

No original evidence was found. Corner was re-established by single proportionate measure between opposite Section corners, East and West.

Research on file with the Ontonagon County Remonumentation Program Representative.

DEED GROUP APPROVAL  
*Earl W. Applekamp*  
 COUNTY REPRESENTATIVE 6-9-99

C. Description of monument for corner and accessories established to perpetuate locating the position of the corner:

At the corner position I set a 2 1/2" x 30" split base aluminum pipe with a 3" cap stamped to read: County Remonumentation, T50N R42W, 1/4, S8, S17, 1999, P.S. 17610. I established three bearing trees and a reference object.

Nail in 11" Hemlock	S69°W	19.51'	-	Nail in 12" Hemlock	S14°E	33.83
Nail in 6" Hemlock	N19°E	30.90'	-	6' Steel Sign Post	West	0.77

Copper Rang Company Coordinates N-24719.38 feet E-27368.58 feet



Signed by Earl W. Applekamp  
 Surveyor's Michigan License No. 17610

Date May 26, 1999