

APR 25 1995

COMMISSION

LAND CORNER RECORDATION CERTIFICATE
Filing Requirement of Act 74, Mich. P.A. 1970

For corners in

<u>ONTONAGON</u> (County)	Located in:	Corner Code #
1. Public Land Survey	T <u>50</u> R <u>42</u>	<u>E-3</u>
	T _____ R _____	_____
	T _____ R _____	_____
	T _____ R _____	_____
2. Property Controlling in Section	S _____ T _____ R _____	_____
	S _____ T _____ R _____	_____
3. Miscellaneous Property in Sec.	S _____ T _____ R _____	_____
	S _____ T _____ R _____	_____

Recorded December 5 1994
 at 2:05 of clock P. M. in
 Liber 3 page 228
Julie M. Mader Deputy
 Register of Deeds

Register of Deeds Stamp & File Number

4. Lot No. _____, Recorded Plat _____
 5. Private Claims _____

Section Corner 4, 5, 8 & 9, T50N R42W

I, Earl W. Applekamp in a field survey on November 05, 1994, do hereby certify that under requirements of P.A. 74, Michigan P.A. of 1970, the corner points mentioned in lines 1 and 2 above were in conformance with regulations and rules therefore as required in the current manual of survey instructions of the United States Department of the Interior, Bureau of Land Management or by a decree of a Court of Law and/or that the corner points mentioned in lines 3, 4 and 5 above were in conformance with the rules of the Michigan Board of Land Surveyors or by a Decree of a Court of Law; established, re-established, monumented, re-monumented, recovered, found as expressed below:

NOTE: Not more than 4 corners, all in the same town and range, may be recorded on this certificate.

A. Description of original monument and accessories and/or subsequent restoration:

Corner established by William Burt, Deputy Surveyor, August 1845.
 Set Tamarack Post.

Original Bearing Trees:

Sugar Maple	12"	N41°E	34 Links	(22.44')
Yellow Birch	16"	S65°W	32 Links	(21.12')

B. Description of corner evidence found and/or method applied in restoring or reestablishing corner:

At the corner position there has been a concrete monument in existence since mid 1940. This monument has been used as the initial point for the Copper Range co-ordinate system. It has a value of N-30000.00 and E-30000.00. It has been used as the starting point for all the plats in the town of White Pine.


Research on file with County Remonumentation Program Representative.

C. Description of monument for corner and accessories established to perpetuate locating the position of the corner:

At the corner position the existing 19" diameter concrete monument was left to mark the corner. It has a 1" steel pin projecting 2" above the concrete. The Section numbers are embedded in the concrete. I established the following objects to tie in the corner.

- Center Sewer M.H. Cover N44°W, 51.18'
- Conc. Block Storage Bldg. S09°W, 418.55'
- SE Cor. Brick Bldg. S50°W, 379.36'
- Center M.H. Cover S05°W, 259.64'
- Steel Sign Post East, 2.15'

ONTONAGON COUNTY
PEER APPROVED
EW Applekamp
Out Co Rep
 11-30-94

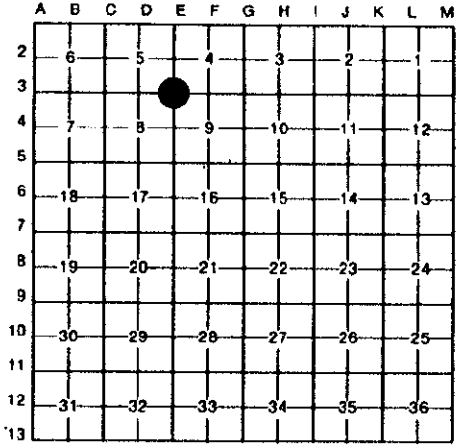

Signed by Earl W. Applekamp Date November 28, 1994
 Surveyor's Michigan License No. 17610