


LAND CORNER RECORDATION CERTIFICATE
 Filing Requirement of Act 74, Mich. P.A. 1970

For corners in

<u>ONTONAGON</u> (County)	Located In:	Corner Code #
1. Public Land Survey	T <u>50N</u> R <u>42W</u>	<u>F-1</u>
	T ___ R ___	_____
	T ___ R ___	_____
	T ___ R ___	_____
2. Property Controlling in Section	S ___ T ___ R ___	_____
	S ___ T ___ R ___	_____
3. Miscellaneous Property in Sec.	S ___ T ___ R ___	_____
	S ___ T ___ R ___	_____

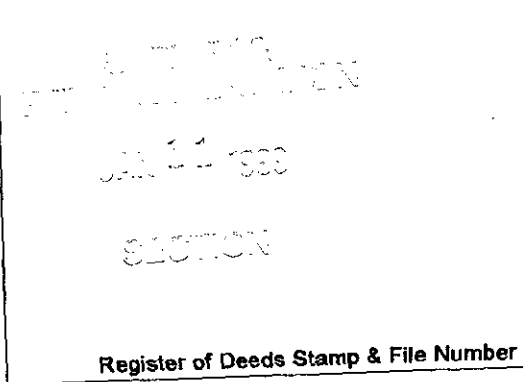

4. Lot No. _____, Recorded Plat _____
 5. Private Claims _____

North 1/4 Corner, Section 4, T50N R42W on 5th Correction Line.

I, Earl W. Applekamp, in a field survey on May 26, 1998 do hereby state that under requirements of P.A. 74, Michigan P.A. of 1970, the corner points mentioned in lines 1 and 2 above were in conformance with regulations and rules therefore as required in the current manual of survey instructions of the United States Department of the Interior, Bureau of Land Management or by a decree of a Court of Law and/or that the corner points mentioned in lines 3, 4 and 5 above were in conformance with the rules of the Michigan Board of Land Surveyors or by a Decree of a Court of Law, established, re-established, monumented, recovered, found as expressed below:

NOTE: Not more than 2 corners, all in the same town and range, may be recorded on this certificate.

A	B	C	D	E	F	G	H	I	J	K	L	M
1												
2	6		5		4		3		2		1	
3												
4	7		8		9		10		11		12	
5												
6	18		17		16		15		14		13	
7												
8	19		20		21		22		23		24	
9												
10	30		29		28		27		26		25	
11												
12	31		32		33		34		35		36	
13												

A. Description of original monument and accessories and/or subsequent restoration:

Corner was not established on original survey.

DEED GROUP APPROVAL
Earl W. Applekamp
 COUNTY REGISTERED
 7-22-98


B. Description of corner evidence found and/or method applied in restoring or reestablishing corner:

Corner was established by single proportionate measure between the NW and NE Corners of Section 4, T50N R42W and on line between the SW and SE Corners of Section 31, T51N R41W. Corner has a coordinate of N 34935.85 and E 32616.34 Copper Range Company Datum.

Research on file with the Ontonagon County Remonumentation Program Representative.

C. Description of monument for corner and accessories established to perpetuate locating the position of the corner:

At the corner position I set a 5/8"X12" rebar with a 3" cap stamped to read: County Remonumentation, T50N R42W, 1/4, S4, 1998, P.S. 17610. Cap is 6" below a seldom used gravel road. I established 5 reference objects.

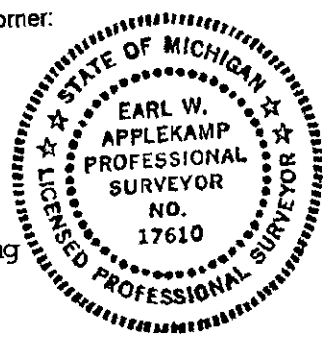

- NE Cor. Conc. Mill Bldg., S46°W, 227.71' - NW Cor. Natural Gas Reducing
- NW Cor. Conc. Mill Bldg., S64°W, 299.79' - Bldg. S81°E, 374.98 feet
- Nail in Power Pole, N88°E 189.32' - 6' Steel Sign Post, S02°W, 19.70'

Signed by Earl W. Applekamp
 Surveyor's Michigan License No. 17610

Date June 24, 1998