

LAND CORNER RECORDATION CERTIFICATE
 Filing Requirement of Act 74, Mich. P.A. 1970

For corners in

<u>ONTONAGON</u> (County)	Located In:	Corner Code #
1. Public Land Survey	T <u>50NR 42W</u>	<u>F-5</u>
	T ___ R ___	_____
	T ___ R ___	_____
	T ___ R ___	_____
2. Property Controlling in Section	S ___ T ___ R ___	_____
	S ___ T ___ R ___	_____
3. Miscellaneous Property in Sec.	S ___ T ___ R ___	_____
	S ___ T ___ R ___	_____


SURVEY & REMONUMENTATION
MAR 23 2000
SECTION
 Register of Deeds Stamp & File Number

4. Lot No. _____, Recorded Plat _____
 5. Private Claims _____

1/4 Corner common to Sections 9 & 16, T50N R42W.

I, Earl W. Applekamp, in a field survey on April 16, 1999 do hereby state that under requirements of P.A. 74, Michigan P.A. of 1970, the corner points mentioned in lines 1 and 2 above were in conformance with regulations and rules therefore as required in the current manual of survey instructions of the United States Department of the Interior, Bureau of Land Management or by a decree of a Court of Law and for that the corner points mentioned in lines 3, 4 and 5 above were in conformance with the rules of the Michigan Board of Land Surveyors or by a Decree of a Court of Law; established, re-established, monumented, recovered, found as expressed below:

NOTE: Not more than 2 corners, all in the same town and range, may be recorded on this certificate.

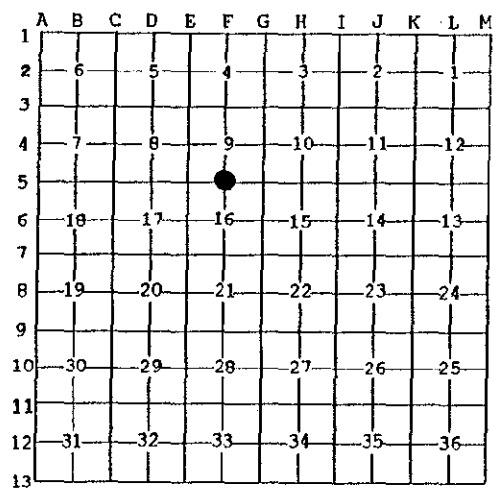

A. Description of original monument and accessories and/or subsequent restoration:

Original corner established by Austin Burt, U.S. Deputy Surveyor, June 14, 1848. Set Hemlock Post.

ORIGINAL BEARING TREES:

7" Hemlock	S35°E	19.80 feet
12" Sugar Maple	N05°W	9.24 feet

PEER GROUP APPROVED
Earl W. Applekamp
 COUNTY REPRESENTATIVE
 5-11-99

B. Description of corner evidence found and/or method applied in restoring or reestablishing corner:

No original evidence was found. Corner position falls near the intersection of Highway M-64 and the L.P. Walsh Road. MDOT highway drawings dated November 1958 indicate corner position is 0.16 feet East of center-line and 34.42 feet North of the P.C. There is a monument box at the P.C. Nothing was found at the corner position. The Highway drawings give a distance to the Section Corner East. This was in agreement with my findings. I accepted this position and monumented the corner.

Research on file with the Ontonagon County Remonumentation Program Representative.

C. Description of monument for corner and accessories established to perpetuate locating the position of the corner:

At the corner position I placed a railroad spike in the blacktop surface of the Highway. I established two reference monuments which are 2 1/2" X 30" split base aluminum pipe with a 3" cap stamped to read: County Remonumentation, T50N R42W, S9, S16, 1/4, R.M., 1999, P.S. 17610. The corner is witnessed with the following:

REF. MON.	N69°-37'-58"W	94.41 feet with a ^{6'} Steel Sign Post	N69°W	0.55 feet
REF. MON.	N52°-15'-26"E	84.47 feet with a 6' Steel Sign Post	N52°E	0.67 feet
Nail in Power Pole	S29°-56'-21"E	133.51 feet		
Copper Range Coordinates	N24760.43 feet	E32611.60 feet		



Signed by Earl W. Applekamp
 Surveyor's Michigan License No. 17610

Date April 23, 1999