

LAND CORNER RECORDATION CERTIFICATE
Filing Requirement of Act 74, Mich. P.A. 1970


For corners in

ONTONAGON
(County)

Located In:

Corner Code #

1. Public Land Survey	T 50N R 42W	G-2
	T R	
	T R	
	T R	
2. Property Controlling in Section	S T R	
	S T R	
3. Miscellaneous Property in Sec.	S T R	
	S T R	

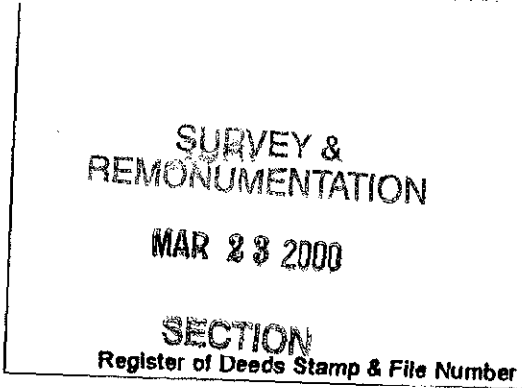


4. Lot No. _____, Recorded Plat _____
5. Private Claims _____

1/4 Corner common to Sections 3 & 4, T50N R42W.

I, Earl W. Applekamp, in a field survey on May 21, 19 99 do hereby state that under requirements of P.A. 74, Michigan P.A. of 1970, the corner points mentioned in lines 1 and 2 above were in conformance with regulations and rules therefore as required in the current manual of survey instructions of the United States Department of the Interior, Bureau of Land Management or by a decree of a Court of Law and/or that the corner points mentioned in lines 3, 4 and 5 above were in conformance with the rules of the Michigan Board of Land Surveyors or by a Decree of a Court of Law; established, re-established, monumented, recovered, found as expressed below:

NOTE: Not more than 2 corners, all in the same town and range, may be recorded on this certificate.

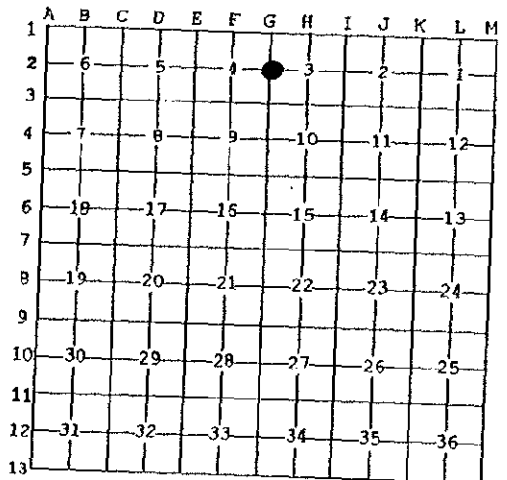

A. Description of original monument and accessories and/or subsequent restoration:

Original corner established by Austin Burt, U.S. Deputy Surveyor, June 15, 1848. Set Sugar Post.

ORIGINAL BEARING TREES:

14" Lynn	S72°E	13.86 feet
8" Lynn	N65°W	15.84 feet

PEER GROUP APPROVED
Earl W. Applekamp
COUNTY REPRESENTATIVE 6-9-99

B. Description of corner evidence found and/or method applied in restoring or reestablishing corner:

No original evidence of the original corner remain. Area has been disturbed by Mining Company activity. Corner was re-established by single proportionate measure on line between opposite Section Corners, North & South. This position falls in a 10 foot deep diversion ditch. I established a witness corner North and South on the Section Line from the actual corner position. These monuments were witnessed with three bearing trees and a Steel Sign Post. These are described in "C" below.

Research on file with the Ontonagon County Remonumentation Program Representative.

C. Description of monument for corner and accessories established to perpetuate locating the position of the corner:

I set 2 witness corners to the corner, which are, 2 1/2" X 30" split base aluminum pipe with a 3" cap stamped to read: County Remonumentation, T50N R42W, 1/4, W.C., S3, S4, 1999, P.S. 17610. One witness corner is N00°-00'-28"W along the section line 78 feet. Bearing trees to this W.C. are nail in 7" twin maples N81°E, 35.36', Nail in 8" Aspen N39°W, 47.52'; Nail in 7" Aspen N18°E, 20.95'; the second witness corner is S00°-00'-28"E along the Section Line 10.00 feet. Bearing trees to this W.C. are nail in 8" Aspen S02°W, 16.42'; nail in 9" Maple, S13°W, 36.17'; nail in 6" Aspen, S58°W, 28.26 feet.

Copper Range Coordinates are N-32637.82 feet E-35246.37 feet

Signed by Earl W. Applekamp

Date May 25, 1999

Surveyor's Michigan License No. 17610

