

SURVEY & REMONUMENTATION

APR 29 1996

COMMISSION

LAND CORNER RECORDATION CERTIFICATE
Filing Requirement of Act 74, Mich. P.A. 1970

JUDITH D. ROEHM 07/19/95
 Ontonagon County 10:28
 LC 3/284 JEM Feet: 9.00
 Page 1 of 1

For corners in
Ontonagon
 (County)

Located In:	Corner Code #
T 50 N R 42 W	G-13 ✓
T 49 R 42	G-1
T _____ R _____	_____
T _____ R _____	_____
S _____ T _____ R _____	_____
S _____ T _____ R _____	_____
S _____ T _____ R _____	_____
S _____ T _____ R _____	_____

- Public Land Survey
- Property Controlling in Section
- Miscellaneous Property in Sec.

Register of Deeds Stamp & File Number

- Lot No. _____, Recorded Plat _____
- Private Claims _____

Section Corner 33,34,3 & 4; T.49-50 N., R.42 W.

I, Richard L. Drahn, in a field survey on June 8, 19 95, do hereby certify that under requirements of P.A. 74, Michigan P.A. of 1970, the corner points mentioned in lines 1 and 2 above were in conformance with regulations and rules therefore as required in the current manual of survey instructions of the United States Department of the Interior, Bureau of Land Management or by a decree of a Court of Law and/or that the corner points mentioned in lines 3, 4 and 5 above were in conformance with the rules of the Michigan Board of Land Surveyors or by a Decree of a Court of Law; established, re-established, monumented, re-monumented, recovered, found as expressed below:

	A	B	C	D	E	F	G	H	I	J	K	L	M
2	6	5	4	3	2	1							
3													
4	7	8	9	10	11	12							
5													
6	18	17	16	15	14	13							
7													
8	19	20	21	22	23	24							
9													
10	30	29	28	27	26	25							
11													
12	31	32	33	34	35	36							
13													

NOTE: Not more than 4 corners, all in the same town and range, may be recorded on this certificate.

A. Description of original monument and accessories and/or subsequent restoration:
 Corner established by William Burt on August 18, 1847. Original bearing trees: --- Spruce 12", N.62 E., 36 links (23.76') --- Sugar 6", N.32 W., 20 links (13.20'). Bearing trees by William Burt on June 12, 1848: --- Sugar 14", S.11 W. 34 links (22.44') --- Hemlock 30", S.20E., 31 links (20.46') ---

Corner recovered by Richard L. Drahn, RLS 21564 on 8/24/77 by field retracement to natural features and line trees N, S, E & W and to recovered corners E, W & S. He set a 2" x 5' iron pipe with a three inch stamped brass cap and the following (1995 conditions in parentheses)

B. Description of corner evidence found and/or method applied in restoring or reestablishing corner:			
7" (8")	Surag Maple	S.43 W. (S.45 W.)	34.0 ft. (34.05')
5" (6")	Sugar Maple	N.75 W. (N.73 W.)	50.8 ft. (50.79)
4" (5")	Sugar Maple	N.89 E. (N.87 E.)	59.0 ft. (58.92')
7'	Steel Rail	S.04 E. (S.06 E.)	1.5 ft. (1.55")


Corner recovered as described in good condition near northerly clearing limits of E - W power line.

Corner recorder in Liber 1, Page 159 of Ontonagon County Records on 4/25/79.

PEER GROUP APPROVED
Earl W. Applekamp
 COUNTY REPRESENTATIVE 7-18-95

C. Description of monument for corner and accessories established to perpetuate locating the position of the corner:
 From the above described monument I blazed and scribed the following:

8" Sugar Maple N.20 E. 19.44 feet

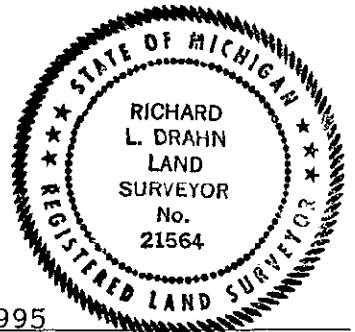

Signed by Richard L. Drahn
 Surveyor's Michigan License No. 21564

Date June 9, 1995