

SURVEY & REMONUMENTATION

APR 29 1996

COMMISSION

JUDITH D. ROEHM
 Ontonagon County
 LC 3/311 JEN Fee: 9.00
 Page 1 of 1

LAND CORNER RECORDATION CERTIFICATE
Filing Requirement of Act 74, Mich. P.A. 1970

For corners in

<u>Ontonagon</u> (County)	Located In:	Corner Code #
1. Public Land Survey	T 49 NR 43 W.	C-1
	T 50 NR 43 W.	C-13 ✓
	T _____ R _____	_____
	T _____ R _____	_____
2. Property Controlling in Section	S _____ T _____ R _____	_____
	S _____ T _____ R _____	_____
3. Miscellaneous Property in Sec.	S _____ T _____ R _____	_____
	S _____ T _____ R _____	_____

Register of Deeds Stamp & File Number

- 4. Lot No. _____, Recorded Plat _____
- 5. Private Claims _____

Sec. Cor. 5, 6, 31 & 32; T.49-50 N., R.43 W.

I, Richard L. Drahn in a field survey on August 23, 19 95, do hereby certify that under requirements of P.A. 74, Michigan P.A. of 1970, the corner points mentioned in lines 1 and 2 above were in conformance with regulations and rules therefore as required in the current manual of survey instructions of the United States Department of the Interior, Bureau of Land Management or by a decree of a Court of Law and/or that the corner points mentioned in lines 3, 4 and 5 above were in conformance with the rules of the Michigan Board of Land Surveyors or by a Decree of a Court of Law; established, re-established, monumented, re-monumented, recovered, found as expressed below:

NOTE: Not more than 4 corners, all in the same town and range, may be recorded on this certificate.

	A	B	C	D	E	F	G	H	I	J	K	L	M
2	6	5	4	3	2	1							
3													
4	7	8	9	10	11	12							
5													
6	18	17	16	15	14	13							
7													
8	19	20	21	22	23	24							
9													
10	30	29	28	27	26	25							
11													
12	31	32	33	34	35	36							
13													

A. Description of original monument and accessories and/or subsequent restoration:

Corner established by John Burt in 1847. Original B.T.s: --- Spruce 16" N.15 E. 46 links (30.36') --- Sugar Maple 18" N.30 W. 26 links (17.16') --- Sugar Maple 8" S.85 W. 17links (11.22') --- Cedar 14" S.20 E. 16 links (10.56')

Corner restored by Donald D. Lappala, RLS 12585 on 8/6/68 from the stump remains of the first two B.T.s and the scribed remains of the Cedar windfall. He set a 2" by 5' long galvanized iron pipe with a 3" stamped brass cap and the following new B.T.s: --- 14" (18") Hemlock N.08 E. (N.11 E.) 19.6' (19.85') --- 12" Hemlock (15") S.20 E. (S.23 E.) 23.6' (23.63') --- 6" (12") Hemlock S.46 W. (S.50 W.) 24.3' (24.15') ---.

B. Description of corner evidence found and/or method applied in restoring or reestablishing corner:

Corner recorded in Ontonagon County in USFS Liber, Page A-5 on 4/1/69.

Act 74 research form on file with Ontonagon County records.


Recovered monument as described and bearing trees as described in parentheses as above. A stump hole remains from the original NW B.T. and scribing is still present on the original Cedar B.T. windfall.

C. Description of monument for corner and accessories established to perpetuate locating the position of the corner:

Bearing objects referenced:

- 4" X 4" X 7' Cedar sign post N.40 E. 3.70'
- 6' Steel sign rail N.50 W. 3.18'

PEER GROUP APPROVED
Paul [Signature] 9-20-95
 COUNTY REPRESENTATIVE

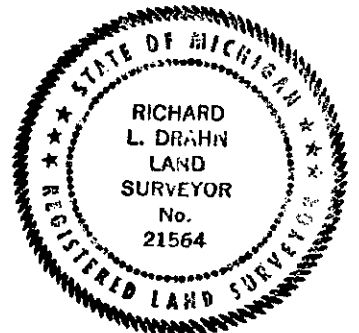

Signed by Richard L. Drahn Date September 11, 1995

Surveyor's Michigan License No. 21564