

LAND CORNER RECORDATION CERTIFICATE

FILING REQUIREMENT OF ACT 74, MICH. P.A.1970

FOR CORNERS OF--	LOCATED IN--	CORNER CODE NUMBER
1. PUBLIC LAND SURVEY	T. 51N N. S., R. 37 E. W.	D11, D9
2. PROPERTY CONTROLLING IN SECTION	, T. _____ N. S., R. _____ E. W.	_____
3. MISCELLANEOUS PROPERTY IN SECTION	, T. _____ N. S., R. _____ E. W.	_____
4. LOT NO. _____, RECORDED PLAT _____		
5. PRIVATE CLAIMS _____		

REGISTER OF DEEDS STAMP AND FILING NUMBER

I, Keith L. Sackett, do hereby certify that under requirements of P.A. 74, Michigan P.A. of 1970, the corner points mentioned in lines 1 and 2 above were, in a field survey on See below, 19____, established, re-established, monumented, re-monumented, recovered or restored as expressed below and in conformance with regulations and rules therefore as required in the current manual of survey instructions of the United States Department of the Interior, Bureau of Land Management or by a decree of a court of law. Furthermore, that the corner points mentioned in lines 3, 4 and 5 above were, in a field survey on _____, 19____, found, recovered, restored, established or re-established as expressed below and in conformance with the rules of the Michigan State Board of Registration for Land Surveyors or, by a Decree of a Court of law:

A. Description of original monument and accessories and/or subsequent restoration:

Corner D11: Original monument and accessories not found. Found 1" I.D. iron pipe 18" above ground on east side of old C. R. railroad on top of a 15 ft. bank. This corner was found by William Waara May 31, 1939.

Corner D9: Original monument and accessories not found. Found 1" I.D. iron pipe 2 ft. above ground. This pipe found by W. Waara April 9, 1938 and at that time had two original bearing trees standing.

B. Description of corner evidence found and/or method applied in restoring or re-establishing corner:

Corner D11: Re-established corner April 26, 1976 at pipe.

Corner D9: Re-established corner May 12, 1976 at pipe.

C. Description of monument for corner and accessories established to perpetuate locating the position of the corner:

Corner D11: 1" I.D. iron pipe 18" above ground.
 14" Spruce S66°E 60.2 ft. 1/4S, NBT
 4" Maple S24°W 11.1 ft. 1/4S, NBT
 Post with Forest Service location poster S26°E 15.8 ft.

Corner D9: 1" I.D. iron pipe 2 ft. above ground.
 13" Sugar S57°E 30.5 ft. 1/4S, NBT
 10" Elm N23°E 30.5 ft. 1/4S, NBT
 10" Sugar with old location poster N18°W 13.8 ft.


SIGNED BY _____ DATE _____

SURVEYOR'S MICHIGAN REGISTRATION NO. _____

FOR STATE AND UNITED STATES AGENCIES:

SIGNED BY _____ DATE _____

APPROVED AND SIGNED BY Keith L. Sackett DATE July 28, 1975
CHIEF OF SURVEY PARTY
 MICHIGAN REGISTERED LAND SURVEYOR
 Keith L. Sackett

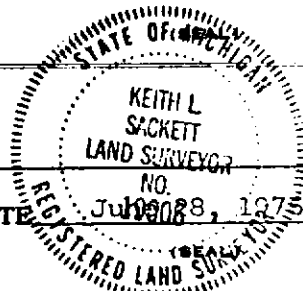

SURVEYOR'S MICHIGAN REGISTRATION NO. 16009