

# LAND CORNER RECORDATION CERTIFICATE

## FILING REQUIREMENT OF ACT 74, MICH. P.A. 1970

ONTONAGON CO.

FOR CORNERS OF--	LOCATED IN--	CORNER CODE NUMBER
1. PUBLIC LAND SURVEY _____	T. <u>51N</u> N. S., R. <u>37W</u> E. W.	MC Between M12 & M13 <u>B13</u>
2. PROPERTY CONTROLLING IN SECTION _____	T. _____ N. S., R. _____ E. W.	_____
3. MISCELLANEOUS PROPERTY IN SECTION _____	T. _____ N. S., R. _____ E. W.	_____
4. LOT NO. _____, RECORDED PLAT _____		
5. PRIVATE CLAIMS _____		

REGISTER OF DEEDS STAMP AND FILING NUMBER

I, Keith L. Sackett, do hereby certify that under requirements of P.A. 74, Michigan P.A. of 1970, the corner points mentioned in lines 1 and 2 above were, in a field survey on see below, 19\_\_\_\_, established, re-established, monumented, re-monumented, recovered or restored as expressed below and in conformance with regulations and rules therefore as required in the current manual of survey instructions of the United States Department of the Interior, Bureau of Land Management or by a decree of a court of law. Furthermore, that the corner points mentioned in lines 3, 4 and 5 above were, in a field survey on \_\_\_\_\_, 19\_\_\_\_, found, recovered, restored, established or re-established as expressed below and in conformance with the rules of the Michigan State Board of Registration for Land Surveyors or, by a Decree of a Court of law:

**A. Description of original monument and accessories and/or subsequent restoration:**

Corner MC Between M12 & M13: Original monument and accessories not found. Found M.S.H.D. witnesses: 12" Birch N25°W 25.42 Ft.  
12" Pine Stump N15°E 23.55 Ft.  
10" Oak S65°E 44.50 Ft.

Corner B13: Original monument and accessories not found. Found 1-3/4" Iron pipe 3 ft. high. Found by W. A. Waara in 1939. Found Forest Service Location Poster on dead stub, S41°W, 18.0 Ft.

**B. Description of corner evidence found and/or method applied in restoring or re-establishing corner:**

Corner MC Between M12 & M13: Restored 6-4-79 from M.S.H.D. witnesses.

Corner B13: Restored 6-13-79 at pipe.

**C. Description of monument for corner and accessories established to perpetuate locating the position of the corner:**

Corner MC Between M12 & M13: Set 1" I.D. x 36" iron pipe with 4" aluminum cap.  
18" W. Pine N38°W 33.4 Ft. MC, NBT  
23" W. Pine N89°E 70.4 Ft. MC, NBT  
Concrete Row Marker N07°E 12.2 Ft.

Corner B13: 1-3/4" iron pipe 3 ft. high.  
12" Maple S62°E 13.7 Ft. 1/4 S, NBT  
7" Maple N13°E 21.5 Ft. 1/4 S, NBT  
9" Y. Birch N72°W 26.8 Ft. 1/4 S, NBT

SIGNED BY \_\_\_\_\_ DATE \_\_\_\_\_

SURVEYOR'S MICHIGAN REGISTRATION NO. \_\_\_\_\_


(SEAL)

FOR STATE AND UNITED STATES AGENCIES:

SIGNED BY \_\_\_\_\_ DATE \_\_\_\_\_

APPROVED AND SIGNED BY Keith L. Sackett DATE 2/5/80

CHIEF OF SURVEY PARTY  
  
MICHIGAN REGISTERED LAND SURVEYOR  
 Keith L. Sackett  
 Michigan Dept. of Natural Resources

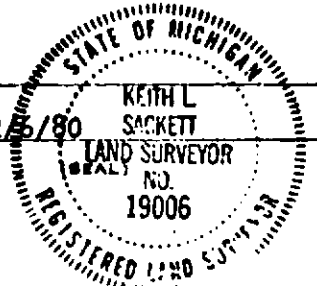

SURVEYOR'S MICHIGAN REGISTRATION NO. 19006