

LAND CORNER RECORDATION CERTIFICATE
Filing Requirement of Act 74, Mich. P.A. 1970
Ontonagon County Remonumentation Corner

Ontonagon County LC 5/86
Rec. Date 06/25/98 Time 12:06
RECORDING FEE: 9.00

For corners in

- 1. Public Land Survey Located in: T51N R37W A-12
2. Property Controlling in Section S T R
3. Miscellaneous Property in Sec. S T R
4. Lot No. Recorded Plat
5. Private Claims

Register of Deeds Stamp & File Number
SUMMARY & REMONUMENTATION
JAN 11 1999
SECTION

I, Joseph C. Domitrovich, in a field survey on June 16, 1998, do hereby state that under requirements of P.A. 74, Michigan P.A. of 1970, the corner points mentioned in lines 1 and 2 above were in conformance with regulations and rules therefore as required in the current manual of survey instructions of the United States Department of the Interior, Bureau of Land Management or by a decree of a Court of Law and for that the corner points mentioned in lines 3, 4 and 5 above were in conformance with the rules of the Michigan Board of Land Surveyors or by a Decree of a Court of Law; established, re-established, monumented, recovered, found as expressed below:

Grid table with columns A-L and rows 1-13. Cell (12, 31) contains a dot.

NOTE: Not more than 2 corners, all in the same town and range, may be recorded on this certificate.

A. Description of original monument and accessories and/or subsequent restoration:

(A-12) 1/4 Corner Common to Section 31, T51N, R37W & Section 36, T51N, R38W

- 1845 - Austin Burt set post
16" Sugar S 31° W 39 links
12" Sugar N 63° W 22 links

- 1980 - Keith L. Sackett, P.S. 19006, for Michigan DNR, recorded this corner in the Ontonagon County Register of Deeds Office, in Liber 1, Page 201 of Corner Records. He found a drill bit set by M.C. Larsen from Cedar B.T. not in original notes. He established 3 scribed N.B.T.s:
4" Sugar S 03° E 12.1'
14" Oak N 82° E 8.9'
6" Y. Birch N 10° W 12.2'

B. Description of corner evidence found and/or method applied in restoring or reestablishing corner:

I found a very old 1 1/2" star drill bit as called for by Sackett. I also recovered all 3 of his N.B.T.s. It appears that this drill bit has been used as the 1/4 Corner for many years.

I accepted the drill bit as the 1/4 Corner. It falls in the roots of a 20" Oak. I replaced the drill bit with a 3/4" aluminum rod and stamped cap.

Research on file with County Remonumentation Representative.


Signature of Paul W. Gabelkamp, COUNTY CLERK, dated 6-17-98

C. Description of monument for corner and accessories established to perpetuate locating the position of the corner:

Corner is a 3/4" x 36" aluminum rod with a 3" diameter aluminum cap stamped to read: COUNTY REMONUMENTATION; S.31, S.36; T.51N, R.37W, R.38W; 1/4; 1998; P.S. 37273.

Witnesses:

- 20" Leaning Oak N 50° W 1.66'
8" Yellow Birch N 06° W 12.79' (DNR - 12.2' to face)
24" Oak N 82° E 9.55' (DNR - 8.9' to face)
5" Sugar Maple S 06° E 12.16' (DNR - 12.1' to face)
Steel Sign Post South 2.73' (to face)
SW Cor. Section 31 S 00° 29' 29" E 2665.69'

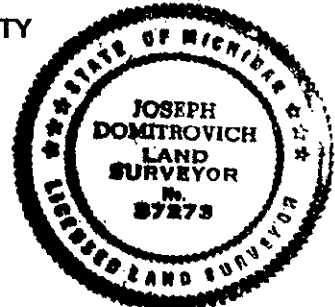

NOTE: Bearings to witness objects are magnetic. Distances are to a nail in side of the witness object unless noted.

Signed by J.C. Domitrovich

Date 6-17-98

Surveyor's Michigan License No. 37273