


LAND CORNER RECORDATION CERTIFICATE
Filing Requirement of Act 74, Mich. P.A. 1970 of 1
Ontonagon County Remonumentation Corner

JUDITH D. BOEHM
 Ontonagon County
 LC 5-143
 Rec. Date 09/26/98 Time 13:30
 RECORDING FEE 9.00

For corners in

Ontonagon County	Located in:	Corner Code #
1. Public Land Survey	T51N R37W	B-11
	T R	
	T R	
	T R	
2. Property Controlling in Section	S T R	
	S T R	
3. Miscellaneous Property in Sec.	S T R	
	S T R	
4. Lot No.	Recorded Plat	
5. Private Claims		

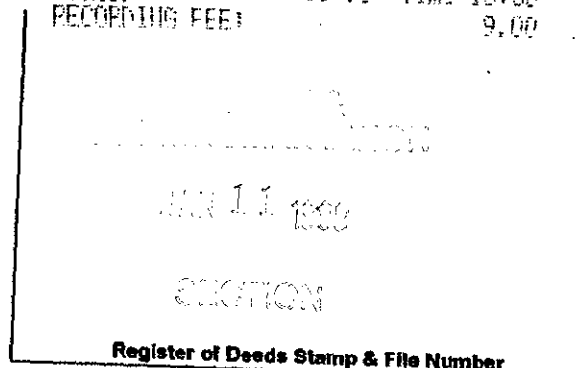

A	B	C	D	E	F	G	H	I	J	K	L	H
1												
2	6	5	4	3	2	1						
3												
4	7	8	9	10	11	12						
5												
6	18	17	16	15	14	13						
7												
8	19	20	21	22	23	24						
9												
10	30	29	28	27	26	25						
11												
12	31	32	33	34	35	36						
13												

I, Joseph C. Domitrovich, in a field survey on August 13, 1998, do hereby state that under requirements of P.A. 74, Michigan P.A. of 1970, the corner points mentioned in lines 1 and 2 above were in conformance with regulations and rules therefore as required in the current manual of survey instructions of the United States Department of the Interior, Bureau of Land Management or by a decree of a Court of Law and for that the corner points mentioned in lines 3, 4 and 5 above were in conformance with the rules of the Michigan Board of Land Surveyors or by a Decree of a Court of Law; established, re-established, monumented, recovered, found as expressed below:

NOTE: Not more than 2 corners, all in the same town and range, may be recorded on this certificate.

A. Description of original monument and accessories and/or subsequent restoration:

(B-11) 1/4 Corner Common to Sections 30 & 31, T51N, R37W

1846 - Sylvester W. Higgins set post
 16" Sugar N 50° E 28 links
 10" Sugar S 10° E 4 links

1957 - Michigan State Highway Department (M.S.H.D.), in the M-38 Highway plans, found a 1" I.D. pipe at the corner. They show a distance East to the centerline of M-38. They established three bearing trees:

12" Maple S 15° E 10.75'
 8" Ash S 70° W 16.85'
 14" Maple N 86° E 40.74'

1976 - Keith Sackett, P.S. 19006, for Michigan DNR, found M.S.H.D. pipe and replaced it with a 1" x 36" iron pipe and a 4" aluminum cap. He used one M.S.H.D. B.T. (the Maple bearing S 15° E) and established another N.B.T.:

10" Ash S 87° W 19.6'

B. Description of corner evidence found and/or method applied in restoring or reestablishing corner:

I found no remains of the original corner. I found the monument called for by Sackett and his N.B.T.s. This monument also matches the position called for by M.S.H.D. The distance East to the centerline of M-38 works well with M.S.H.D. distance (182.77' meas., 182.07' M.S.H.D.). The distance West to the Northwest Corner works reasonably well with GLO: (2760.25' meas., 2742.3' GLO). I accepted the pipe as the corner and have monumented it as such.


Research on file with County Remonumentation Representative.

C. Description of monument for corner and accessories established to perpetuate locating the position of the corner:

Corner is a 1 1/4" x 36" iron pipe with a 4" diameter aluminum cap stamped to read: STATE OF MICHIGAN; 30, 31; 1/4; T.51N, R.37W; R.L.S. 19006; 5/17/76. The corner falls in Southerly ditch of Highway M-26.

Witnesses:

22" Maple	S 13° E	11.66'	(DNR, M.S.H.D.; added nail)
9" Basswood	S 58° W	18.26'	
14" Ash	S 89° W	19.75'	(DNR; added nail)
1/2" Iron Pin #37273	N 00°37'09" W	6.40'	
Steel Sign Rail	East	0.92'	(to face)
NW Cor. Section 31	N 89°02'30" W	2760.25'	

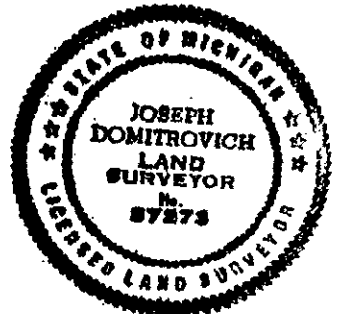

NOTE: Bearings to witness objects are magnetic. Distances are to a nail in side of the witness object unless noted.

Signed by Joseph C. Domitrovich

Date 8-19-98

Surveyor's Michigan License No. 37273