

JUDITH D. ROEHM 1F
Ontonagon County

LAND CORNER RECORDATION CERTIFICATE
Filing Requirement of Act 74, Mich. P.A. 1970
Ontonagon County Remonumentation Corner

Page 1 of 1 LC 5/ 89
 Rec. Date 06/25/98 Time 12:09
 RECORDING FEE: 9.00

For corners in

Ontonagon County	Located in:	Corner Code #
1. Public Land Survey	T51N R37W	B-13
	T R	
	T R	
	T R	
2. Property Controlling in Section	S T R	
	S T R	
3. Miscellaneous Property in Sec.	S T R	
	S T R	
4. Lot No. , Recorded Plat		
5. Private Claims		

JAN 11 1999

SECTION

Register of Deeds Stamp & File Number

	A	B	C	D	E	F	G	H	I	J	K	L	M
1													
2	6	5	4	3	2	1							
3													
4	7	8	9	10	11	12							
5													
6	18	17	16	15	14	13							
7													
8	19	20	21	22	23	24							
9													
10	30	29	28	27	26	25							
11													
12	31	32	33	34	35	36							
13													

I, Joseph C. Domitrovich, in a field survey on June 11, 1998, do hereby state that under requirements of P.A. 74, Michigan P.A. of 1970, the corner points mentioned in lines 1 and 2 above were in conformance with regulations and rules therefore as required in the current manual of survey instructions of the United States Department of the Interior, Bureau of Land Management or by a decree of a Court of Law and for that the corner points mentioned in lines 3, 4 and 5 above were in conformance with the rules of the Michigan Board of Land Surveyors or by a Decree of a Court of Law; established, re-established, monumented, recovered, found as expressed below:

NOTE: Not more than 2 corners, all in the same town and range, may be recorded on this certificate.

A. Description of original monument and accessories and/or subsequent restoration:

(B-13) South 1/4 Corner of Section 31, T51N, R37W
 Corner is on 5th Correction Line.

- 1845** - Austin Burt set post.
 8" Maple N 25° E 26 links
 12" Cedar N 32° W 35 links

1939 - Copper Range Corner Records: A 1 1/2" I.P. 3 feet above ground was found at the corner which worked well with original B.T. (14" Cedar - down). He placed a location poster on a 9" Basswood S 40° W 18 feet.

1980 - Keith Sackett, P.S. 19006, for Michigan DNR, found a 1 1/4" iron pipe 3' high and a location poster on a dead stub S 41° W 18 feet. The corner is recorded at Ontonagon County Register of Deeds, Liber 1, Page 202 of Corner Records. He established 3 scribed N.B.T.s:
 12" Maple S 62° E 13.7'
 7" Maple N 13° E 21.5'
 9" Yellow Birch N 72° W 26.8'

DEED GROUP APPROVED
Carl W. Applekamp
 COUNTY REGISTER OF DEEDS 6-17-98

B. Description of corner evidence found and/or method applied in restoring or reestablishing corner:

I found the iron pipe as called for by Sackett and Copper Range Records. I found the fallen remains of the Cedar B.T. as called for by copper Range. I also recovered the remains of Sackett's N.B.T.s. The 7" Maple to the NE is now fallen. I accepted the iron pipe as the 1/4 corner and drove it down, placing an aluminum rod and cap in it. I established 3 new bearing trees and placed a nail in the side of the remaining DNR N.B.T.s. The DNR distances were to the notch in the face of the trees.


Research on file with County Remonumentation Representative.

C. Description of monument for corner and accessories established to perpetuate locating the position of the corner:

Corner is a 1/2" x 48" aluminum rod driven into a 2" O.D. iron pipe, with a 3" diameter aluminum cap stamped to read: COUNTY REMONUMENTATION; S. 31; 1/4; S.C.; T.51N, R.37W; 1998; P.S. 37273. Corner falls in a Cedar swamp.

Witnesses:

8" Balsam	North	27.43'	
13" Maple	S 58° E	14.19'	(DNR - 13.7' to face)
Steel Sign Post	South	0.69'	(to face)
6" Basswood	S 47° W	17.23'	
11" Y. Birch	N 72° W	27.0'	(DNR - 26.8' to face)
SE Cor. Section 31	S 89° 43' 05" E	2654.84'	(2640' GLO)
SW Cor. Section 31	S 89° 58' 59" W	2778.36'	(2772.0' GLO)

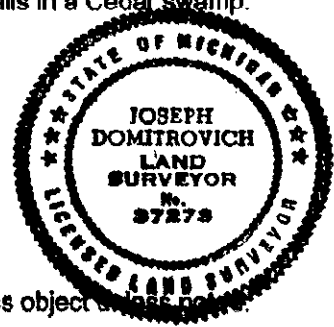

NOTE: Bearings to witness objects are magnetic. Distances are to a nail in side of the witness object unless noted.

Signed by Joseph C. Domitrovich

Date 6-17-98

Surveyor's Michigan License No. 37273