

**LAND CORNER RECORDATION CERTIFICATE**  
 Filing Requirement of Act 74, Mich. P.A. 1970

For corners in

Ontonagon Located In: \_\_\_\_\_ Corner Code # \_\_\_\_\_  
 (County)

1. Public Land Survey T 51N R 37W \_\_\_\_\_ D-13  
 T \_\_\_\_\_ R \_\_\_\_\_  
 T \_\_\_\_\_ R \_\_\_\_\_  
 T \_\_\_\_\_ R \_\_\_\_\_

2. Property Controlling S \_\_\_\_\_ T \_\_\_\_\_ R \_\_\_\_\_  
 in Section S \_\_\_\_\_ T \_\_\_\_\_ R \_\_\_\_\_

3. Miscellaneous S \_\_\_\_\_ T \_\_\_\_\_ R \_\_\_\_\_  
 Property in Sec. S \_\_\_\_\_ T \_\_\_\_\_ R \_\_\_\_\_

**SURVEY &  
 REMONUMENTATION**

**APR 07 1998**

**SECTION**

Register of Deeds Stamp & File Number

4. Lot No. \_\_\_\_\_, Recorded Plat \_\_\_\_\_  
 5. Private Claims \_\_\_\_\_

I, Joseph C. Domitrovich, in a field survey on November 24, 19 97 do hereby state that under requirements of P.A. 74, Michigan P.A. of 1970, the corner points mentioned in lines 1 and 2 above were in conformance with regulations and rules therefore as required in the current manual of survey instructions of the United States Department of the Interior, Bureau of Land Management or by a decree of a Court of Law and/or that the corner points mentioned in lines 3, 4 and 5 above were in conformance with the rules of the Michigan Board of Land Surveyors or by a Decree of a Court of Law; established, re-established, monumented, recovered, found as expressed below:

NOTE: Not more than 2 corners, all in the same town and range, may be recorded on this certificate.

	A	B	C	D	E	F	G	H	I	J	K	L	M
1													
2		6		5		4		3		2		1	
3													
4		7		8		9		10		11		12	
5													
6		18		17		16		15		14		13	
7													
8		19		20		21		22		23		24	
9													
10		30		29		28		27		26		25	
11													
12		31		32		33		34		35		36	
13													

**(D-13) South 1/4 Corner of Section 32, T51N, R37W**

A. Description of original monument and accessories and/or subsequent restoration:

1845 - Austin Burt set post

14" Sugar N 68° E 31 links  
 7" Sugar N 47° W 24 links

1980 - Keith Sackett, P.S. 19006, for Michigan DNR, computed this corner midway between Section Corners to set the Center 1/4 Corner of Section 32, but he did not set a monument.

B. Description of corner evidence found and/or method applied in restoring or reestablishing corner:

Original corner and accessories were not recovered. Road construction and farming in the area of this corner destroyed all original evidence.

I re-established the corner position midway between Section Corners and on line with fence to West and distant centerline of Post Office Road to East. This position works well with other corners on the Correction line.

*BEER GROUP APPROVAL*  
*Earl W. Applekamp*  
 COUNTY SURVEYOR 12-01-97


Research on file with County Remonumentation Representative.

C. Description of monument for corner and accessories established to perpetuate locating the position of the corner:

Corner is a 5/8" x 24" iron pin, with a 3" diameter bronze cap stamped to read: COUNTY REMONUMENTATION; 1/4; S. 32; T.51N, R.37W; S.C.; 1997; P.S. 37273. Corner falls on the extension of the centerline of Post Office Road to East, a fence to the West, and 15 feet West of the centerline extended of Post Office Road to the North.

Witnesses:

12" Ash S 83° W 52.15'  
 8" Ash N 34° W 23.20'  
 11" Ash N 50° E 102.20'  
 Steel Sign Post East 28.40' (to face)

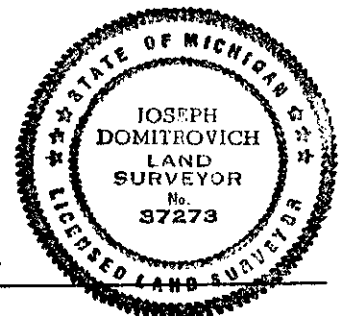

NOTE: Bearings are magnetic. Distances are to nail in side of witness objects unless noted.

Signed by Joseph C. Domitrovich Date 11/30/97  
 Surveyor's Michigan License No. 37273