

LAND CORNER RECORDATION CERTIFICATE

Filing Requirement of Act 74, Mich. P.A. 1970  
Ontonagon County Remonumentation Corner

Page 1 of 1  
Ontonagon County

LC 54214

REC'D Rec. Date 07/27/99  
RECORDING FEE: 9.00

For corners in

Ontonagon County	Located in:	Corner Code #
1. Public Land Survey	T51N R37W	H - 13
	T R	
	T R	
	T R	
2. Property Controlling in Section	S T R	
	S T R	
3. Miscellaneous Property in Sec.	S T R	
	S T R	
4. Lot No.	Recorded Plat	
5. Private Claims		

SURVEY & REMONUMENTATION

MAR 28 2000

SECTION

Register of Deeds Stamp & File Number

	A	B	C	D	E	F	G	H	I	J	K	L	M
1													
2	6		5		4		3		2		1		
3													
4	7		8		9		10		11		12		
5													
6	18		17		16		15		14		13		
7													
8	19		20		21		22		23		24		
9													
10	30		29		28		27		26		25		
11													
12	31		32		33		34		35		36		
13													

I, Joseph C. Domitrovich, in a field survey on July 10, 1999, do hereby state that under requirements of P.A. 74, Michigan P.A. of 1970, the corner points mentioned in lines 1 and 2 above were in conformance with regulations and rules therefore as required in the current manual of survey instructions of the United States Department of the Interior, Bureau of Land Management or by a decree of a Court of Law and /or that the corner points mentioned in lines 3, 4 and 5 above were in conformance with the rules of the Michigan Board of Land Surveyors or by a Decree of a Court of Law; established, re-established, monumented, recovered, found as expressed below:

NOTE: Not more than 2 corners, all in the same town and range, may be recorded on this certificate.

A. Description of original monument and accessories and/or subsequent restoration:

(H-13) 1/4 Corner on South Side of Section 34, T51N, R37W. (Corner is on the 5th Correction Line.)

1895 - Austin Burt set a post.

7" Fir	N48°E	9 links
14" Cedar	N52°W	24 links

B. Description of corner evidence found and/or method applied in restoring or reestablishing corner:

I found no remains of the original corner or accessories. At the corner position I found a 1 1/2" x 24" iron pipe and an aluminum location poster on a down Balsam. I also found an old squared cedar post lying flat next to the pipe. The position of the pipe works very well with other corners recovered along the 5th correction line to the East and West. I accepted it as the 1/4 corner and replaced it with a County Monument.

Research on file with County Remonumentation Representative.


PEER GROUP APPROVED  
*Carl W. Applbaum* 7-20-99  
COUNTY REMONUMENTATION

C. Description of monument for corner and accessories established to perpetuate locating the position of the corner:

Corner is a 2 1/2" x 30" aluminum pipe with a 3" diameter aluminum cap stamped to read: COUNTY REMONUMENTATION; T.51N., R.37W.; S.34; 1/4; S.C.; 1999; P.S. 37273. Ties:

13" Soft Maple	N33°E	21.62'
12" White Birch	S55°E	16.23'
11" Spruce	S70°W	33.34'
Steel Sign Rail	West	0.81' (to face)
6" Hard Maple	N25°W	18.21'
SE Corner Sec. 34	N89°59'23"E	2634.24'
S 1/4 Corner Sec. 33	S89°53'49"W	5257.88'

(Across Firesteel River Valley)

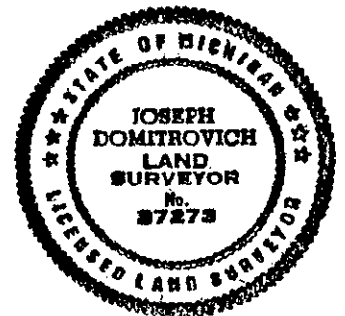

NOTE: Bearings to witness objects are magnetic. Distances are to a nail in side of the witness object unless noted.

Signed by *J. C. Domitrovich*

Date 7/20/99

Surveyor's Michigan License No. 37273