


JUDITH D. ROEHN
IF

LAND CORNER RECORDATION CERTIFICATE Ontonagon County
Filing Requirement of Act 74, Mich. P.A. 1970 of 1 LC 5-127
Ontonagon County Remonumentation Corner Rec. Date 09/03/99 Time 09:21
 RECORDING FEE: 9.00

For corners in

Ontonagon County	Located in:	Corner Code #
1. Public Land Survey	T51N R37W	J-11
	T R	
	T R	
	T R	
2. Property Controlling in Section	S T R	
	S T R	
3. Miscellaneous Property in Sec.	S T R	
	S T R	
4. Lot No.	Recorded Plat	
5. Private Claims		

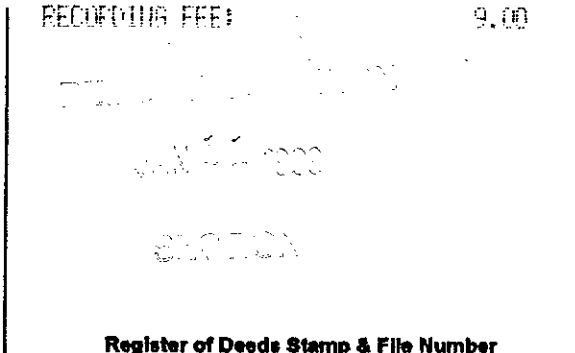

I, Joseph C. Domitrovich, in a field survey on July 8, 1998, do hereby state that under requirements of P.A. 74, Michigan P.A. of 1970, the corner points mentioned in lines 1 and 2 above were in conformance with regulations and rules therefore as required in the current manual of survey instructions of the United States Department of the Interior, Bureau of Land Management or by a decree of a Court of Law and /or that the corner points mentioned in lines 3, 4 and 5 above were in conformance with the rules of the Michigan Board of Land Surveyors or by a Decree of a Court of Law; established, re-established, monumented, recovered, found as expressed below:

NOTE: Not more than 2 corners, all in the same town and range, may be recorded on this certificate.

	A	B	C	D	E	F	G	H	I	J	K	L	M
1													
2	6	5		4		3		2		1			
3													
4	7	8		9		10		11		12			
5													
6	16	17		16		15		14		13			
7													
8	19	20		21		22		23		24			
9													
10	30	29		28		27		26		25			
11													
12	31	32		33		34		35		36			
13													

A. Description of original monument and accessories and/or subsequent restoration:
(J-11) ¼ Corner Common to Section 26 & 35, T51N, R37W

1846 - Sylvester W. Higgins set post
 12" Poplar N 80° E 30 links
 12" Balsam S 75° E 23 links

FEEB GROUP APPROVAL
Paul W. [Signature]
 COUNTY REPRESENTATIVE

1980 - Keith Sackett, R.L.S. 19006 for Michigan Department of Natural Resources, found a 1 ¼" I.D. iron pipe 15" above ground at the 1/16 Corner to the West, as well as the Northwest Corner of Section 35 but does not mention the North ¼ Corner.

B. Description of corner evidence found and/or method applied in restoring or reestablishing corner:

I found no remains of the original corner or accessories. I found Sackett's Northwest Corner and 1/16 Corner to the West. The area of the Corner has been disturbed by excavation for a culvert. I created a position for the North ¼ Corner by projecting a line from the Northwest Corner across the 1/16 Corner and doubling the distance. This position falls close to the intersection of the centerline of North-South Airport Road and an old fenceline to the West. I accepted this computed ¼ Corner position and monumented it. Distances to Section Corners East and West vary considerably from record GLO. I believe this to be a result of either gross error or fraudulent work by the original GLO Surveyor.

Research on file with County Remonumentation Representative.


C. Description of monument for corner and accessories established to perpetuate locating the position of the corner:

Corner is a 5/8" x 24" iron pin with a 3" diameter aluminum cap stamped to read: COUNTY REMONUMENTATION; S.26, S.35; T.51N, R.37W; ¼; 1998; P.S. 37273. I also established a reference monument (R.M.) to the West, a 2 ½" x 30" aluminum pipe with a 3" diameter aluminum cap stamped to indicate that the ¼ Corner is East a distance of 33.16 feet. The corner falls in approximate centerline of North-South gravel road and 2 feet North of extension of an old fenceline to the West.

Witnesses:

4" Cedar	N 47° E	35.85'
½" Iron w/ cap #37273	N 89° 30' 01" E	33.00'
13" Poplar	S 59° E	46.20'
R.M.	S 87° 39' 21" W	33.16'
2" O.D. Iron Pipe	S 89° 46' 04" W	1399.04'
NW Cor. Section 35	S 89° 46' 04" W	2798.08'
NE Cor. Section 35	N 89° 30' 01" E	2619.76'

(West 1/16 Cor. between [unclear] c. 26 & 35)

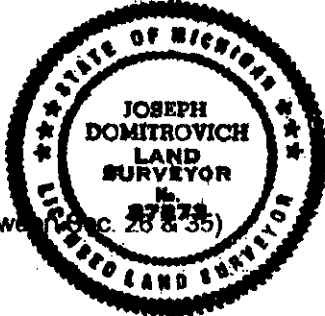

NOTE: Bearings to witness objects are magnetic. Distances are to a nail in side of the witness object unless noted.

Signed by J. C. Domitrovich

Date 7/22/98

Surveyor's Michigan License No. 37273