

LAND CORNER RECORDATION CERTIFICATE

Filing Requirement of Act 74, Mich. P.A. 1970

Ontonagon County Remonumentation Corner

Ontonagon County

Page 1 of 1 LC 5/ 92

VEN Rec. Date 06/25/98 Time 12:09

RECORDING FEE: 9.00

For corners in

Ontonagon County Located in: Corner Code #

- 1. Public Land Survey T51N R37W J-13
T R
T R
T R
2. Property Controlling in Section S S T R
S T R
3. Miscellaneous Property in Sec. S T R
S T R

- 4. Lot No. , Recorded Plat
5. Private Claims

Register of Deeds Stamp & File Number. Includes date stamp JUN 11 1998 and ELECTRON.

I, Joseph C. Domitrovich, in a field survey on June 11, 1998, do hereby state that under requirements of P.A. 74, Michigan P.A. of 1970, the corner points mentioned in lines 1 and 2 above were in conformance with regulations and rules therefore as required in the current manual of survey instructions of the United States Department of the Interior, Bureau of Land Management or by a decree of a Court of Law and/or that the corner points mentioned in lines 3, 4 and 5 above were in conformance with the rules of the Michigan Board of Land Surveyors or by a Decree of a Court of Law, established, re-established, monumented, recovered, found as expressed below:

NOTE: Not more than 2 corners, all in the same town and range, may be recorded on this certificate.

A. Description of original monument and accessories and/or subsequent restoration:

(J-13) South 1/4 Corner of Sections 35, T51N, R37W
Corner is on the 5th Correction Line.

1845 - Austin Burt set a post
16" Birch N 68° E 19 links
16" Birch N 50° W 17 links

1967 - Donald D. Lappala, P.S. 12585, for the U.S. Forest Service, recorded the corner (in Forest Service Liber at Ontonagon County Register of Deeds). He found and accepted a 1 1/4" iron pipe at a fence intersection. It worked well with the line tree to the West and stump hole of the first Birch bearing tree. He established the following N.B.O.s:
9" Sugar Maple N 83° E 31.0'
5" Sugar Maple N 67° W 17.8'
Conc. R.O.W. Marker N 15° E 38.6'
He placed a 2" Galvanized pipe at the corner with a 3" bronze cap stamped: T51N, R37W; S.C.; 1/4; S-35; R.L.S. 12585; 1967.

PEER GROUP APPROVED
Carl W. [Signature]
COUNTY REGISTER OF DEEDS 6-17-98

B. Description of corner evidence found and/or method applied in restoring or reestablishing corner:

I found the forest Service monument as called for by Lappala as well as his 3 bearing objects. The depression and rotten wood of the original 16" Birch B.T. to the NE work well with this position. Distance West to the SW Corner of Section 35 works well:

S 89° 50' 45" W 2635.40' (meas.) 2640' (GLO)

I accepted the corner as found. I added nails to sides of his N.B.T.s.

Research on file with County Remonumentation Representative.

C. Description of monument for corner and accessories established to perpetuate locating the position of the corner:

Corner is a 2" galvanized pipe with a 3" diameter bronze cap as called for by Lappala in Part A above.

Witnesses:


- Concrete R.O.W. Marker N 13° E 38.57' (existing—no nail)
12" Hard Maple N 83° E 30.85' (existing—added nail)
Steel Sign Post S 45° E 2.66' (to face)
6" Soft Maple S 09° E 13.11'
Old Wood U.S.F.S. Sign Post S 15° W 3.8' (no nail)
8" Hard Maple N 65° W 17.65' (existing—added nail)

NOTE: Bearings to witness objects are magnetic. Distances are to a nail in side of the witness object unless noted.

Signed by [Signature]

Date 6-17-98

Surveyor's Michigan License No. 37273

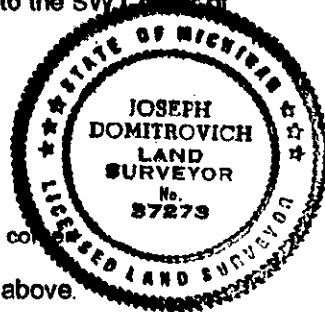

Grid table with columns A-M and rows 1-13. Contains numbers 1-36 in a grid pattern.