

JUDITH D. ROEMM
IF

LAND CORNER RECORDATION CERTIFICATE
Filing Requirement of Act 74, Mich. P.A. 1970
Ontonagon County Remonumentation Corner

LC 5/130
 Rec. Date 08/03/98 Time 09:22
 RECORDING FEE: 9.00

For corners in

| | | |
|------------------------------------|---------------|---------------|
| Ontonagon County | Located in: | Corner Code # |
| 1. Public Land Survey | T51N R37W | K-13 |
| | T R | |
| | T R | |
| | T R | |
| 2. Property Controlling in Section | S T R | |
| | S T R | |
| 3. Miscellaneous Property in Sec. | S T R | |
| | S T R | |
| 4. Lot No. | Recorded Plat | |
| 5. Private Claims | | |

ONTONAGON COUNTY REGISTER OF DEEDS

JAN 11 1998

SECTION

Register of Deeds Stamp & File Number

I, Joseph C. Domitrovich, in a field survey on July 3, 1998, do hereby state that under requirements of P.A. 74, Michigan P.A. of 1970, the corner points mentioned in lines 1 and 2 above were in conformance with regulations and rules therefore as required in the current manual of survey instructions of the United States Department of the Interior, Bureau of Land Management or by a decree of a Court of Law and for that the corner points mentioned in lines 3, 4 and 5 above were in conformance with the rules of the Michigan Board of Land Surveyors or by a Decree of a Court of Law, established, re-established, monumented, recovered, found as expressed below:

NOTE: Not more than 2 corners, all in the same town and range, may be recorded on this certificate.

A. Description of original monument and accessories and/or subsequent restoration:
 (K-13) Standard Corner Common to Sections 35 & 36, T51N, R37W

- 1845 - Austin Burt set post
 - 18" Hemlock N 65° E 26 links
 - 16" Hemlock N 61° W 41 links
- 1955 - Michigan State Highway Department, M.S.H.D., in M-35 Highway Plans Project 66-15, show a 1" iron pipe at this corner, 57.28 feet South of centerline of M-38.
- 1967 - Donald D. Lappala, R.L.S. 12585, recorded this corner in Liber 1, Page 17 of Corner Records and in Forest Service Liber at the Ontonagon County Register of Deeds Office. He restored the corner by single proportionate measurement between the Standard 1/4 Corner of Section 35 and the Standard Meander Corner of Section 36. He set a 2" I.D. x 5' concrete filled galvanized iron pipe, capped with a 3" bronze cap. He established 3 NBTs:
 - 8" Red Pine S 89° E 21.2'
 - 7" Red Pine S 22° E 9.9'
 - 5" Red Pine S 29° W 19.9'

PEER GROUP APPROVAL
Paul W. Lappala
 COUNTY REGISTER OF DEEDS 7-22-98

B. Description of corner evidence found and/or method applied in restoring or reestablishing corner:

I found no remains of the original corner or accessories. I recovered the monument and accessories as recorded by Lappala. A Department of Conservation aluminum tag, dated 1962, facing away from Lappala's corner, indicates a pipe for the corner. I found no remains of this pipe called for by M.S.H.D. Lappala does not mention it. I have determined from the Highway Plans that the pipe fell 20.7' North of Lappala's corner. After evaluating both positions I have determined that the M.S.H.D. pipe would be too far North of the 5th Correction line, as evidenced by the accepted corners to the East and West. I have therefore accepted Lappala's corner as the correct Section Corner.


Research on file with County Remonumentation Representative.

C. Description of monument for corner and accessories established to perpetuate locating the position of the corner:

Corner is a 2" x 5' long concrete filled galvanized iron pipe with a 3" diameter bronze cap stamped to read: S.C.; S.35, S.36; T.51N, R.37W; 1967; R.L.S. 12585. The corner falls 78 feet South of the centerline of M-38.

Witnesses:

| | | | |
|--------------------------|-----------------|----------|-----------------------------|
| 12" Red Pine | N 15° W | 5.87' | |
| 10" Red Pine | S 88° E | 21.34' | (existing, added nail) |
| 12" Red Pine | S 18° E | 10.05' | (existing, added nail) |
| Wood Forest Service Sign | South | 2.4' | (no nail, distance to side) |
| 12" Red Pine | S 63° W | 19.90' | (existing, added nail) |
| Steel Sign Rail | West | 2.79' | |
| S 1/4 Cor. Section 35 | N 89° 39' 33" W | 2639.95' | |
| E 1/4 Cor. Section 35 | N 01° 22' 46" W | 2687.62' | |

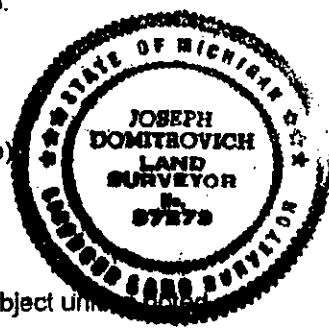

NOTE: Bearings to witness objects are magnetic. Distances are to a nail in side of the witness object unless noted.

Signed by Joseph C. Domitrovich Date 7/22/98

Surveyor's Michigan License No. 37273