

LAND CORNER RECORDATION CERTIFICATE
Filing Requirement of Act 74, Mich. P.A. 1970

For corners in

Ontonagon

(County)

Located in:

Corner Code #

- | | | |
|------------------------------------|-----------------------------|-----------|
| 1. Public Land Survey | T <u>51</u> N R <u>37</u> W | <u>I4</u> |
| | T ___ R ___ | _____ |
| | T ___ R ___ | _____ |
| | T ___ R ___ | _____ |
| 2. Property Controlling in Section | S ___ T ___ R ___ | _____ |
| | S ___ T ___ R ___ | _____ |
| 3. Miscellaneous Property in Sec. | S ___ T ___ R ___ | _____ |
| | S ___ T ___ R ___ | _____ |

Register of Deeds Stamp & File Number

4. Lot No. _____, Recorded Plat _____
 5. Private Claims _____

Jun 25 2002

I, Stephan J. Szyszkoski, in a field survey on _____, 20__ do hereby state that under requirements of P.A. 74, Michigan P.A. of 1970, the corner points mentioned in lines 1 and 2 above were in conformance with regulations and rules therefore as required in the current manual of survey instructions of the United States Department of the Interior, Bureau of Land Management or by a decree of a Court of Law and /or that the corner points mentioned in lines 3, 4 and 5 above were in conformance with the rules of the Michigan Board of Land Surveyors or by a Decree of a Court of Law; established, re-established, monumented, recovered, found as expressed below:

NOTE: Not more than 2 corners, all in the same town and range, may be recorded on this certificate.

A	B	C	D	E	F	G	H	I	J	K	L	M
1												
2	6		5		4		3		2		1	
3												
4	7		8		9		10	●	11		12	
5												
6	18		17		16		15		14		13	
7												
8	19		20		21		22		23		24	
9												
10	30		29		28		27		26		25	
11												
12	31		32		33		34		35		36	
13												

A. Description of original monument and accessories and/or subsequent restoration:

Quarter corner common to Sections 10 and 11. 1846: Established by S.W.Higgins: 1) North between Sections 10 and 11. 2) 0.53 stream 1 S.E. in ravine. 3) 1.50 top ravine. 4) 10.00 In ravine SE and NW. 5) 16.98 Sugar 20 top ravine. 6) 26.00 trap knob 30 feet ascend. 7) 34.00 trap knob 20 feet. 8) 34.82 knob conglomerate Sugar 14. 9) 37.00 top mountain 700 feet NE & SW. 10) 40.00 Set 1/4 post Sugar 16 N85W 11, Sugar 6 N83E 7. Descend. 11) 58.00 Trap knob 1 ch W of line N&S; 12) 70.00 trap knob NE-SW; 13) 80.00 set post cor Sec 2,3,10,11.

B. Description of corner evidence found and/or method applied in restoring or reestablishing corner:

The original post and accessories were not found. Found no evidence of perpetuation. Reestablished the corner according to the record above: Begin at I5, a perpetuated original corner; 1) N1 deg. 09' W true brg. meas.; 2) checks; 3) 2.0 meas.; 4) Checks; 5) 16.1 meas. to top, no sign of Sugar; 6) 25.7 meas. to trap knob 1 ch. west of line; 7) 33.5 meas. 8) 34.8 meas. to knob, no sign of Sugar; 9) 36.9 top mountain NE&SW; 10) 40.000 reestablished and monumented the corner and descend; 11) checks; 12) Does not check from south. Checks good due south from I3 (10.0 ch meas.); 13) 77.3 meas. Find I3 of record, described as a perpetuation of the original, 4.64 ch. E'ly of and at right angles to this line. The true bearing and distance from I4 to I3 is N 5 deg. 57'E 2481.2'. The agreement between my meas. to the features recovered along most of this mile and the original record has convinced me that the original 1/4 corner was located very near to where I have reestablished it. A decision to reestablish this corner midway between section corners would have required disregarding nearly all of the detailed record of this line and I was not willing to do that. I believe Higgins ran this line and set I4 from the south but had previously established I3 and did not correct this line to it.

C. Description of monument for corner and accessories established to perpetuate locating the position of the corner:


Set 1"IDx32" I.pipe with 4" alum. MDNR cap driven 0.8' to bedrock and made firm with a rock mound 3' dia. by 16" high.

Blazed and scribed:

- | | |
|--------------------------|------------|
| 6" Sugar N73E 24.8' | "1/4S N8T" |
| 8" twin Sugar S68E 15.3' | do |
| 8" do S28W 26.1' | do |
| 6" do N22W 16.0' | do |

Set sq'd sugar post adjacent. Bearings are magnetic. Distances are to notch in lower blaze.

Signed by Stephan J. Szyszkoski

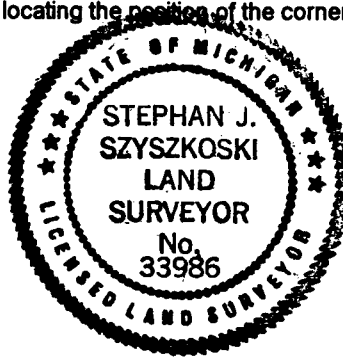

Date 7/17/02

Surveyor's Michigan License No. 33986