

**LAND CORNER RECORDATION CERTIFICATE**  
**Filing Requirement of Act 74, Mich. P.A. 1970**

For corners in  
Ontonagon

(County)

Located In: \_\_\_\_\_ Corner Code # \_\_\_\_\_

- |                                    |   |     |   |     |     |
|------------------------------------|---|-----|---|-----|-----|
| 1. Public Land Survey              | T | 51N | R | 37W | H11 |
|                                    | T |     | R |     |     |
|                                    | T |     | R |     |     |
|                                    | T |     | R |     |     |
| 2. Property Controlling in Section | S |     | T | R   |     |
|                                    | S |     | T | R   |     |
| 3. Miscellaneous Property in Sec.  | S |     | T | R   |     |
|                                    | S |     | T | R   |     |

Register of Deeds Stamp & File Number

4. Lot No. \_\_\_\_\_, Recorded Plat \_\_\_\_\_  
 5. Private Claims \_\_\_\_\_

Jul 18 2000

I, Stephan J. Szyszkoski, in a field survey on \_\_\_\_\_, 20\_\_\_\_ do hereby state that under requirements of P.A. 74, Michigan P.A. of 1970, the corner points mentioned in lines 1 and 2 above were in conformance with regulations and rules therefore as required in the current manual of survey instructions of the United States Department of the Interior, Bureau of Land Management or by a decree of a Court of Law and /or that the corner points mentioned in lines 3, 4 and 5 above were in conformance with the rules of the Michigan Board of Land Surveyors or by a Decree of a Court of Law; established, re-established, monumented, recovered, found as expressed below:

NOTE: Not more than 2 corners, all in the same town and range, may be recorded on this certificate.

	A	B	C	D	E	F	G	H	I	J	K	L	M
1													
2	6		5		4		3		2		1		
3													
4	7		8		9		10		11		12		
5													
6	18		17		16		15		14		13		
7													
8	19		20		21		22		23		24		
9													
10	30		29		28		27		26		25		
11													
12	31		32		33		34		35		36		
13													


A. Description of original monument and accessories and/or subsequent restoration:  
 Quarter corner common to Sections 27 and 34. Established in 1846 by S.W. Higgins: West corrected between 27 and 34...40.00 Set 1/4 Sec post Balsam 9 S30E 19, Poplar 10 N20W 28...80.00 Sec. corner. Found no subsequent record.

B. Description of corner evidence found and/or method applied in restoring or reestablishing corner:

The original post and accessories were not recovered. The mile measures 4976.08' between section corners of record. I found remains of an ancient N-S barbed-wire animal fence in the corner area. The fence has not been maintained for many years and was difficult to trace, often buried deep in the debris on the forest floor, and extending at least 1/4 mile south. Peter Chargo, a local land owner told me that he had come to learn from the previous owner of the N1/2 of the NE1/4 of Section 34, that this was indeed an animal fence installed long ago, located at an approximate or convenient location, and did not signal the location of the original 1/4 corner. Mr. Chargo told me he placed a 1.5" dia. iron pipe at the north end of the fence as a marker, which I found. I also saw remains of an E-W barbed-wire fence crossing south of the N-S fence. I judge the original corner lost and reestablish it midway and on a line of mean true bearing between sections corners. From the corner thus established, Mr. Chargo's pipe bears N80 deg. 22'E (true) 160.04' distant.

C. Description of monument for corner and accessories established to perpetuate locating the position of the corner:

Set 1"IDx32" I.pipe with 4" alum. MDNR cap. Blazed and scribed the following new bearing trees:  
 8"-12" dbl Maple N34E 12.7' "1/4S NBT"  
 7" Maple S65E 18.7' do  
 12" Spruce S18E 31.7' do  
 12" Sugar N61W 23.3' do  
 Squared a 3" Balsam N38W 2.3' to center.  
 Bearings are magnetic. Distances are to notch in lower blaze.

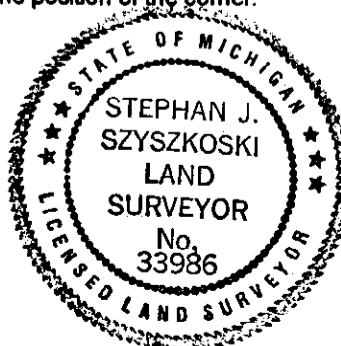

Signed by Stephan J. Szyszkoski  
 Surveyor's Michigan License No. 33986

Date 4/25/02