LAND CORNER RECORDATION CERTIFICATE
Filing Requirement of Act 74, Mich. P.A. 1970 as Amended

For corners in

Ontonagon (County)

		Located In:	Corner Code #
1. Public Land Survey		T 51N R 37W	I9
		T ___ R ___	
		T ___ R ___	
	S ___	T ___ R ___	
2. Property Controlling	S 22	T 51N R 37W	10
in Section	S ___	T ___ R ___	
3. Miscellaneous	S ___	T ___ R ___	
Property in Sec.	S ___	T ___ R ___	

Register of Deeds Stamp & File Number

4. Lot No. _____ , Recorded Plat _____

5. Private Claims

10 May 24 2006
I9 May 18 2006

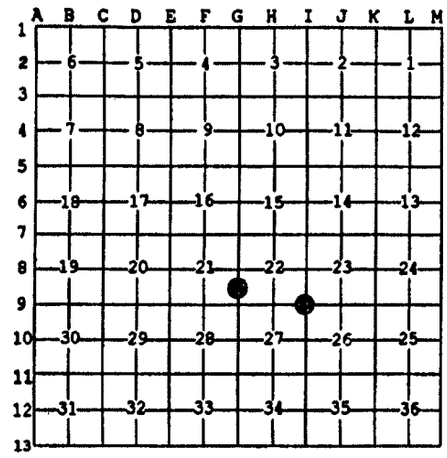

I, Stephan J. Szyszkoski, in a field survey on _____, 20 ____ do hereby state that under requirements of P.A. 74, Michigan P.A. of 1970, the corner points mentioned in lines 1 and 2 above were in conformance with regulations and rules therefore as required in the current manual of survey instructions of the United States Department of the Interior, Bureau of Land Management or by a decree of a Court of Law and /or that the corner points mentioned in lines 3, 4 and 5 above were in conformance with the rules of the Michigan Board of Land Surveyors or by a Decree of a Court of Law; established, re-established, monumented, recovered, found as expressed below:

NOTE: Not more than 2 corners, all in the same town and range, may be recorded on this certificate.

A. Description of original monument and accessories and/or subsequent restoration:

(I9) Corner common to Sections 22-23-26-27. 1846 - Established by S.W.Higgins, Deputy Surveyor: North between Sections 26 & 27 ...80.00 Set post corner Sec. 22, 23, 26, & 27. Balsam 10 S65W 17 links, Y.Birch 20 N20E 17 links. Found no subsequent record.
(10-Sec. 22) South 1/16 corner between Sections 21 and 22. Established in 1976 by K.L.Sackett PS, midway and on line between Section and Quarter corners. Set 1" I.D. x 36" iron pipe with 4" aluminum cap. 6" Sugar S14W 22.1, 5" Maple N03E 21.0', 6" Balsam S83E 3.5', 3" Squared Sugar S50W 2.8'.

B. Description of corner evidence found and/or method applied in restoring or reestablishing corner:

(I9) Found a 3/4" x 7 ft. long iron pipe, projecting 6ft., at record bearing and distance from probable original Y.Birch BT, now 24" DBH, still green, hollow, having several blazes on older blaze overgrowth. No scribing was found. Examination of the annual ring growth shows this tree to be in excess of 100 years old (count incomplete due to rotted heartwood). Distances to Section corners North (80.00 ch. R, 80.743 ch. M), East (79.56 ch. R, 80.859 ch. M), South (80.00 ch. R, 80.298 ch. M), and Quarter corner West (40.12 ch. R, 40.525 ch. M) check reasonably with the original record. I accept the pipe as the best available evidence of the position of the original corner and replace it with a new monument, as described below.
(10-Sec. 22) Recovered the 1976 monument disturbed, bent, with aluminum cap broken. Remonumented the corner at record bearing and distance from the 1976 BTs Maple NE in good condition, Sugar SW now a stump, and squared Sugar SW now down and laying across the corner position. Set a new monument at the corner position and made new witnesses, as described below.

C. Description of monument for corner and accessories established to perpetuate locating the position of the corner:

(I9) Found 3/4" iron pipe, replaced it with 1"IDx32" I.pipe with 4" alum. MDNR cap. Set measuring nails in:
24" Y.Birch N26E 11.7' old blazes (OBT)
12" Sugar East 24.0' mrkd "S23 NBT"
7" W.Spruce S19E 29.8' "S26 NBT"
7" B.Ash N76W 23.4' "S22 NBT"
Bearings are magnetic. Distances are to nail with tag.

(10) Set 1"IDx32" I.pipe with 4" alum. MDNR cap. Set measuring nails in:
8" Maple N09E 21.5' overgrown blazes
7" twin Sugar N80E 30.3'mrkd "1/16S BT"
7" Hemlock S19E 32.4' do
7" Sugar N45W 18.1' do
Set sq'd sugar post adjacent. Bearings are magnetic. Distances are to nail with tag.

STATE OF MICHIGAN
STEPHAN J. SZYSZKOSKI
LAND SURVEYOR
No. 33986
LICENSED LAND SURVEYOR

Signed by Stephan J. Szyszkoski Date 6/19/06

Surveyor's Michigan License No. 33986

For the Michigan Department of Natural Resources, Office of Land and Facilities

FORM APPROVED BY MICHIGAN STATE BOARD OF PROFESSIONAL SURVEYORS, JAN. 28, 1971
Revised May 14, 1975
Revised Jan., 1983
Rervised Oct., 1995