

LAND CORNER RECORDATION CERTIFICATE
Filing Requirement of Act 74, Mich. P.A. 1970 as Amended

For corners in

Ontonagon <small>(County)</small>	Located In:	Corner Code #
1. Public Land Survey	T _____ R _____	_____
	T _____ R _____	_____
	T _____ R _____	_____
2. Property Controlling in Section	S <u>13</u> T <u>51N</u> R <u>37W</u>	<u>7</u>
	S <u>1</u> T <u>51N</u> R <u>37W</u>	<u>14</u>
	S _____ T _____ R _____	_____
3. Miscellaneous Property in Sec.	S _____ T _____ R _____	_____
	S _____ T _____ R _____	_____
4. Lot No. _____, Recorded Plat _____		
5. Private Claims		

Register of Deeds Stamp & File Number

	A	B	C	D	E	F	G	H	I	J	K	L	M
1													
2	6			5			4			3			1
3													
4	7			8			9			10			12
5													
6	18			17			16			15			13
7													
8	19			20			21			22			24
9													
10	30			29			28			27			25
11													
12	31			32			33			34			36
13													

I, Stephan J. Szyszkoski, in a field survey on 06/03/2009 do hereby state that under requirements of P.A. 74, Michigan P.A. of 1970, the corner points mentioned in lines 1 and 2 above were in conformance with regulations and rules therefore as required in the current manual of survey instructions of the United States Department of the Interior, Bureau of Land Management or by a decree of a Court of Law and /or that the corner points mentioned in lines 3, 4 and 5 above were in conformance with the rules of the Michigan Board of Land Surveyors or by a Decree of a Court of Law; established, re-established, monumented, recovered, found as expressed below:

NOTE: Not more than 2 corners, all in the same town and range, may be recorded on this certificate.

A. Description of original monument and accessories and/or subsequent restoration:

(7-Sec. 13) North 1/16 corner between Section 13 T51N-R37W and Section 18 T51N-R36W. Not established in the original survey.

(14-Sec. 1) South 1/16 corner between Section 1 T51N-R37W and Section 6 T51N-R36W. Not established in the original survey.

B. Description of corner evidence found and/or method applied in restoring or reestablishing corner:

(7-Sec. 13) Established the corner midway and on the Range line between Section corner 1320.76' north and Quarter corner 1320.76' south.

(14-Sec. 1) Established the corner midway and on the Range line between Section corner 1318.88' south and Quarter corner 1318.88' north.


C. Description of monument for corner and accessories established to perpetuate locating the position of the corner:

(7) Set 1"IDx32" I.pipe with 4" alum. MDNR cap.
 Set measuring nail with MDNR tag in the side of:
 6" Sugar N09E 18.1' mrkd "1/16S BT"
 5" Sugar South 5.2' do
 9" Maple S80W 28.1' do
 18" Hemlock N41W 35.3' do
 Set sq'd Cedar post adjacent.
 Bearings are magnetic.

(14) Set 1"IDx32" I.pipe with 4" alum. MDNR cap.
 Set measuring nail with MDNR tag in the side of:
 4" Tamarack N03E 15.75' mrkd "1/16S BT"
 8" Hemlock N45E 7.2' do
 9" Tamarack S58E 27.35' do
 12" W.Pine S79W 7.75' do
 Set sq'd Cedar post adjacent.
 Bearings are magnetic.

Signed by *Stephan J. Szyszkoski*
 Surveyor's Michigan License No. 33986

Date 06/16/2009

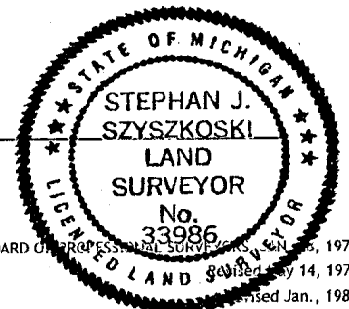

For the Michigan Department of Natural Resources, Office of Land and Facilities