JUDITH D. ROEHM 08/13/96
Ontonagon County 11:00
LC 4/ 150 JDR Fee: 9.00
Page 1 of 1

LAND CORNER RECORDATION CERTIFICATE

Filing Requirement of Act 74, Mich. P.A. 1970

For corners in ONTONAGON (County) Located In: Corner Code #

1. Public Land Survey		T 51N R 38W	E-11
		T___ R___	
		T___ R___	
		T___ R___	
2. Property Controlling	S___	T___ R___	
in Section	S___	T___ R___	
3. Miscellaneous	S___	T___ R___	
Property in Sec.	S___	T___ R___	

SURVEY & REMONUMENTATION
MAY 2 2 1997
COMMISSION

Register of Deeds Stamp & File Number

4. Lot No. _____, Recorded Plat _____
5. Private Claims _____

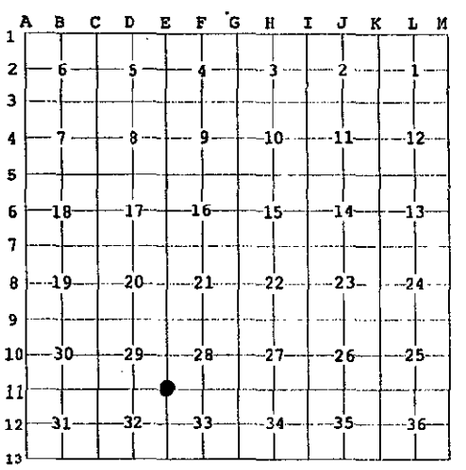

I, GERALD W. CARLSON, in a field survey on August 1ST, 19 96, do hereby state that under requirements of P.A. 74, Michigan P.A. of 1970, the corner points mentioned in lines 1 and 2 above were in conformance with regulations and rules therefore as required in the current manual of survey instructions of the United States Department of the Interior, Bureau of Land Management or by a decree of a Court of Law and/or that the corner points mentioned in lines 3, 4 and 5 above were in conformance with the rules of the Michigan Board of Land Surveyors or by a Decree of a Court of Law; established, re-established, monumented, recovered, found as expressed below:

NOTE: Not more than 2 corners, all in the same town and range, may be recorded on this certificate.

A. Description of original monument and accessories and/or subsequent restoration:
E-11: Section Corner common to Sections 28, 29, 32, and 33, T51N-R38W.
1846: S.W. Higgins' and H. Higgins' original subdivision survey notes describe the corner monument as a wood post referenced by:
16" Sugar N72W, 11 L
15" Sugar S45E, 56 L

Circa 1960 +/-: A Land Corner Record from Copper Range (Now Mead Paper) indicates the corner as a found 18" Basswood Stub with old marks on four sides. Corner is in a stand of second-growth hardwoods on the South side of a swale. Referenced by:
28" Hard Maple N53E, 11' (Old marks and PAL)
16" Hard Maple S08W, 8'
6" Hard Maple N20W, 11' (WAW on tree)
No liber and page given.
Research on file with the Ontonagon County Remonumentation Representative.

B. Description of corner evidence found and/or method applied in restoring or reestablishing corner:
E-11: 1996: A traverse was run South from GPS points near the West 1/4 Corner to a R.A. Mick capped iron South of the stream. This iron was 82.79' too far South according to Mick's 1992 Section 28 survey. The corner position was calculated and set using the 1992 R.A. Mick survey of Section 28. The position checks well with the stream call South 0.50 chains, and to found Corners North and East. The Distance North is 5292.73', and the Distance East is 2636.18'. No evidence of an R.A. Mick monument was found at the corner position.

C. Description of monument for corner and accessories established to perpetuate locating the position of the corner:
E-11: 1996: *Set a 2 3/8" O.D. aluminum pipe capped with a 3 1/4" diameter aluminum tablet Ontonagon County Survey Monument,* stamped as follows to identify the corner: T51N., R38W.; S. 28, S. 29, S. 32, S. 33; 1996; P.S. 24589. Monument is 0.4' above ground, and is approximately halfway up a hill sloping to the South. Corner is also 30.4' North of the C/L of stream.
Established references:

10" Maple	N71W,	25.20'	6" Maple	N63E,	18.40'
6" Maple	S64E,	7.51'	11" Maple	S22W,	1.42'
Green Steel Sign Post w/ Yellow Survey Marker Sign				North,	2.9'

Note: Bearing trees have painted face, butt, and side nail blazes, d.h. measuring nails, and B.T. Tags affixed.
Bk. 51-38, Pg. 50.

PEER GROUP APPROVED
Earl W Applebaum
COUNTY REPRESENTATIVE 08-08-96

STATE OF MICHIGAN
GERALD W. CARLSON
SURVEYOR
No. 24589
LICENSED PROFESSIONAL SURVEYOR

Signed by Gerald W Carlson Date 8-6-96

Surveyor's Michigan License No. 24589

FORM APPROVED BY MICHIGAN STATE BOARD OF PROFESSIONAL SURVEYORS, JAN. 28, 1971
REVISED MAY 14, 1975
REVISED JAN., 1983
REVISED OCT., 1995