

**SURVEY & REMONUMENTATION**

DEC 1 8 1996

**COMMISSION**

JUDITH D. ROEHM  
 Ontonagon County  
 LC 4/ 62 JEM Fee: 9.00  
 Page 1 of 1

**LAND CORNER RECORDATION CERTIFICATE**  
**Filing Requirement of Act 74, Mich. P.A. 1970**

For corners in Ontonagon  
 (County)

Located In:

Corner Code #

- 1. Public Land Survey Section 28 T 51N R 38W G-10  
 T \_\_\_\_\_ R \_\_\_\_\_  
 T \_\_\_\_\_ R \_\_\_\_\_  
 T \_\_\_\_\_ R \_\_\_\_\_
- 2. Property Controlling in Section S \_\_\_\_\_ T \_\_\_\_\_ R \_\_\_\_\_  
 S \_\_\_\_\_ T \_\_\_\_\_ R \_\_\_\_\_
- 3. Miscellaneous Property in Section S \_\_\_\_\_ T \_\_\_\_\_ R \_\_\_\_\_  
 S \_\_\_\_\_ T \_\_\_\_\_ R \_\_\_\_\_

Register of Deeds Stamp & File Number

- 4. Lot No. \_\_\_\_\_, Recorded Plat \_\_\_\_\_
- 5. Private Claims \_\_\_\_\_

One-quarter corner Sections 27 and 28, T51N, R38W

I, John R. Garske, in a field survey on July 26, 19 95, do hereby certify that under requirements of P.A. 74, Michigan P.A. of 1970, the corner points mentioned in lines 1 and 2 above were in conformance with regulations and rules therefore as required in the current manual of survey instructions of the United States Department of the Interior, Bureau of Land Management or by a decree of a Court of Law and/or that the corner points mentioned in lines 3, 4 and 5 above were in conformance with the rules of the Michigan Board of Professional Surveyors or by a Decree of a Court of Law; established, re-established, monumented, re-monumented, recovered, found as expressed below:

A	B	C	D	E	F	G	H	I	J	K	L	N
2	6	5	4	3	2	1						
3												
4	7	8	9	10	11	12						
5												
6	18	17	16	15	14	13						
7												
8	19	20	21	22	23	24						
9												
10	30	29	28	27	26	25						
11												
12	31	32	33	34	35	36						
13												

**NOTE: Not more than 4 corners, all in the same town and range, may be recorded on this certificate.**

**A. Description of original monument and accessories and/or subsequent restoration:**

Original survey by Hiram Higgins, D.S. in 1847. He set a wood post from which a 12" hemlock bears S50°E - 99 links and a 18" Y. birch - N58°W - 38 links.

- 1966± - MDOT plans for U.S. 45 show distance of 741.92 feet to centerline of Hwy. with witnesses for a found 1 1/2" iron pipe: 4" poplar - N05°W - 21.20 feet; 5" poplar - N80°W - 10.60 feet; 3" W. birch - N75°E - 17.46 feet.
- 1992 - Survey by Robert Mick, RLS, notes iron pipe at one-quarter corner.

**B. Description of corner evidence found and/or method applied in restoring or reestablishing corner:**

I found a 1 1/2" iron pipe at the one-quarter corner location as noted by Mick's survey. The pipe is at the edge of a road ditch at the K&W Landfill. All MDOT bearing trees are now gone. The position checks close with the MDOT distance tie to Hwy. 45 centerline and with distance ties shown on Mick's survey to other points found.


Research on file with the Ontonagon County Remonumentation Representative.

**C. Description of monument for corner and accessories established to perpetuate locating the position of the corner:**

I replaced the found iron pipe with a 2 1/2" dia. x 30" long alum. pipe with a 3 1/4" dia. stamped alum. cap from which I established the following bearing trees/reference objects:

- 13" S. maple - N16°E - 90.16 feet
- 8" spruce - N68°E - 40.32 feet
- 6" spruce - S74°E - 18.43 feet
- 6' steel sign post - S25°W - 1.12 feet

PEER GROUP APPROVED  
*Earl W. Applekamp*  
 COUNTY REPRESENTATIVE  
 5-07-96

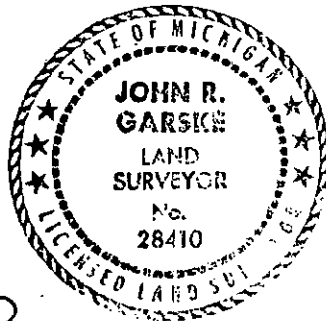

Signed by John R. Garske

Date 28410

Surveyor's Michigan License No. 28410