


LAND CORNER RECORDATION CERTIFICATE

Filing Requirement of Act 74, Mich. P.A. 1970
Ontonagon County Remonumentation Corner

Ontonagon County of 1 LC 5/144
Rec. Date 08/26/98 Time 13:31
RECORDING FEE: 9.00

For corners in

Table with columns: Ontonagon County, Located in:, Corner Code #. Rows include Public Land Survey, Property Controlling in Section, Miscellaneous Property in Sec., Lot No., and Private Claims.

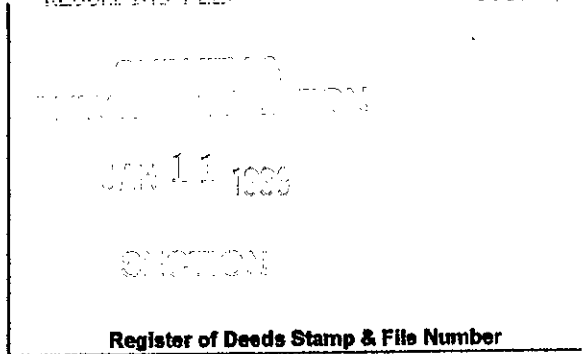

Grid table with columns A-L and rows 1-13, containing numbers 1-36 and a central dot.

I, Joseph C. Domitrovich, in a field survey on August 18, 1998, do hereby state that under requirements of P.A. 74, Michigan P.A. of 1970, the corner points mentioned in lines 1 and 2 above were in conformance with regulations and rules therefore as required in the current manual of survey instructions of the United States Department of the Interior, Bureau of Land Management or by a decree of a Court of Law and for that the corner points mentioned in lines 3, 4 and 5 above were in conformance with the rules of the Michigan Board of Land Surveyors or by a Decree of a Court of Law; established, re-established, monumented, recovered, found as expressed below:

NOTE: Not more than 2 corners, all in the same town and range, may be recorded on this certificate.

A. Description of original monument and accessories and/or subsequent restoration: (I-7) Corner Common to Sections 14, 15, 22 & 23, T51N, R38W

- 1846 - Hiram and Sylvester W. Higgins set post. 16" Sugar N 40° E 50 links, 20" Hemlock S 25° W 45 links

1986 - Robert Mick, P.S. 16939, in his survey recorded in Survey Records, Liber 1, Page 85 at the Ontonagon County Courthouse, found and witnessed the corner but did not indicate what he found.

PEER GROUP APPROVED Paul W Applekamp COUNTY REC. CLERK 8-19-98

B. Description of corner evidence found and/or method applied in restoring or reestablishing corner:

Original corner and accessories and Mick corner were destroyed by road construction. I found three nails with P.S. 16936 tags in trees facing the area of the Corner. I calculated the position of the Corner from Mick's survey. This position falls at centerline of North Firesteel Road to North and South and on extension of old fence lines to East and West. This position works well with occupation. The distance North to Mick's West 1/4 Corner of Section 14 works well (2638.72' meas.; 2640' GLO). Distances to the Corners East and South differ considerably from GLO. I believe this is the result of either gross error or fraudulent work on the part of the original surveyor.


I have accepted the position from the Mick survey as the Section Corner and have monumented it as such.

Research on file with County Remonumentation Representative.

C. Description of monument for corner and accessories established to perpetuate locating the position of the corner:

Corner is a 1/2" iron pin with a 3" diameter aluminum cap stamped to read: COUNTY REMONUMENTATION; S.15, S.14, S.22, S.23; T.51N, R.38W; 1998; P.S. 37273. I also established a reference monument (R.M.) to the West stamped to indicate that the corner is N 88° E 36.26 feet.

Witnesses table with columns: Witness, Bearing, Distance. Includes 4" Ironwood, 6" Dead Elm, 1/2" Iron #37273, 4" Ironwood, 4" Elm, 14' Dead Y. Birch, R.M., S 1/4 Cor. Sec. 14, W 1/4 Cor. Sec. 23.

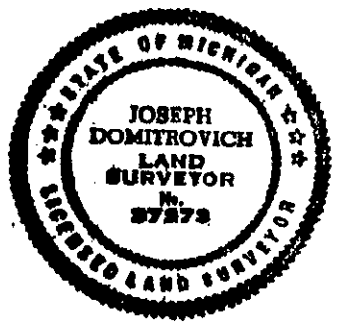

NOTE: Bearings to witness objects are magnetic. Distances are to a nail in side of the witness object unless noted.

Signed by [Signature] Date 8-19-98

Surveyor's Michigan License No. 37273