


LAND CORNER RECORDATION CERTIFICATE
Filing Requirement of Act 74, Mich. P.A. 1970
Ontonagon County Remonumentation Corner

JUDITH L. ROEMER
 Ontonagon County
 5-145
 Rec. Date 08/26/98 Time 13:32
 RECORDATION FEE: 9.00

For corners in

Ontonagon County	Located in:	Corner Code #
1. Public Land Survey	T51N R38W	I-9
	T R	
	T R	
	T R	
2. Property Controlling in Section	S T R	
	S T R	
3. Miscellaneous Property in Sec.	S T R	
	S T R	
4. Lot No. , Recorded Plat		
5. Private Claims		

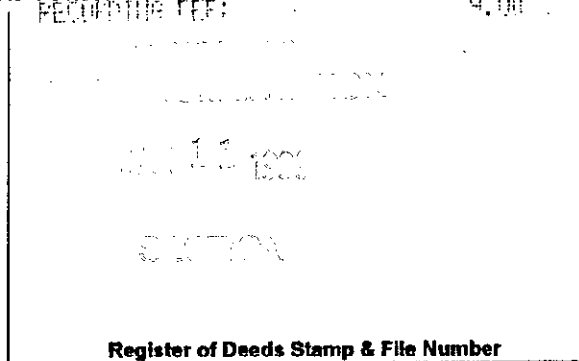

Register of Deeds Stamp & File Number

	A	B	C	D	E	F	G	H	I	J	K	L	M
1													
2	6	5	4	3	2	1							
3													
4	7	8	9	10	11	12							
5													
6	18	17	16	15	14	13							
7													
8	19	20	21	22	23	24							
9													
10	30	29	28	27	26	25							
11													
12	31	32	33	34	35	36							
13													

I, Joseph C. Domitrovich, in a field survey on August 18, 1998, do hereby state that under requirements of P.A. 74, Michigan P.A. of 1970, the corner points mentioned in lines 1 and 2 above were in conformance with regulations and rules therefore as required in the current manual of survey instructions of the United States Department of the Interior, Bureau of Land Management or by a decree of a Court of Law and /or that the corner points mentioned in lines 3, 4 and 5 above were in conformance with the rules of the Michigan Board of Land Surveyors or by a Decree of a Court of Law; established, re-established, monumented, recovered, found as expressed below:

NOTE: Not more than 2 corners, all in the same town and range, may be recorded on this certificate.

A. Description of original monument and accessories and/or subsequent restoration:

(I-9) Corner of Sections 22, 23, 26 & 27, T51N, R38W

1846 - Hiram and Sylvester Higgins set post.
 14" Sugar N 55° E 25 links
 16" Sugar S 70° W 74 links

1996 - Gerald W. Carlson, P.S. 24589, measured distance to this corner from found monuments one mile West, North, and South.
 NW Corner Section 27 S 87°29'17" W 5001.05'
 NE Corner Section 22 N 00°37'14" E 5144.12'
 SE Corner Section 27 S 02°56'13" E 5286.87'

PEER GROUP APPROVED
Earl W. Applekamp
 COUNTY REGISTER
 8-19-98

B. Description of corner evidence found and/or method applied in restoring or reestablishing corner:

I found no remains of the original corner or accessories. I found a 1 3/4" O.D. iron pipe which falls on the extension of North Firesteel Road to the North and a blazed line to the South. An old rusted Forest Service location poster faces the pipe (cannot read date). The stream calls to the South work well with original GLO. Distances to the Section Corners and 1/4 Corners in four directions are either extremely long or short. This is not inconsistent with work done by the original surveyors elsewhere in this Township. This pipe has been used and accepted by surveyors and foresters for many years. I believe it best represents the position of the original Corner and have accepted it as the Section Corner.


Research on file with County Remonumentation Representative.

C. Description of monument for corner and accessories established to perpetuate locating the position of the corner:

Corner is a 3/4" x 3' aluminum rod driven into the 1 3/4" iron pipe with a 3" diameter aluminum cap stamped to read: COUNTY REMONUMENTATION; S.22, S.23, S.26, S.27; T.51N, R.38W; 1998; P.S. 37273.

Witnesses:

8" Hard Maple	N 49° E	16.45'	(yellow Forest Service location poster)
14" Hard Maple	S 80° E	8.12'	(old blaze)
7" Hard Maple	S 14° W	37.35'	
6" Hard Maple	N 50° W	39.80'	
Steel Sign Rail	North	1.79'	(to face)
W 1/4 Cor. Section 23	N 02°23'35" W	2575.82'	
W 1/4 Cor. Section 26	S 01°25'20" W	2703.06'	

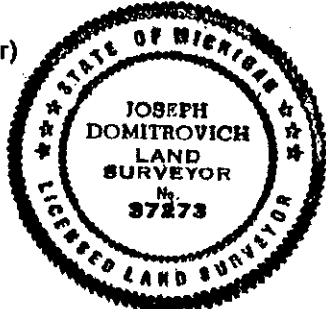

NOTE: Bearings to witness objects are magnetic. Distances are to a nail in side of the witness object unless noted.

Signed by Joseph C. Domitrovich Date 8-19-98

Surveyor's Michigan License No. 37273