


**LAND CORNER RECORDATION CERTIFICATE**  
**Filing Requirement of Act 74, Mich. P.A. 1970**  
**Ontonagon County Remonumentation Corner**

THE STATE OF MICHIGAN  
 Ontonagon County  
 of 1  
 Rec. Date 08-26-98 Time 1:39  
 RECORDING FEE 3.00

For corners in

Ontonagon County	Located in:	Corner Code #
1. Public Land Survey	T51N R38W	L-11
	T R	
	T R	
	T R	
2. Property Controlling in Section	S T R	
	S T R	
3. Miscellaneous Property in Sec.	S T R	
	S T R	
4. Lot No.	Recorded Plat	
5. Private Claims		

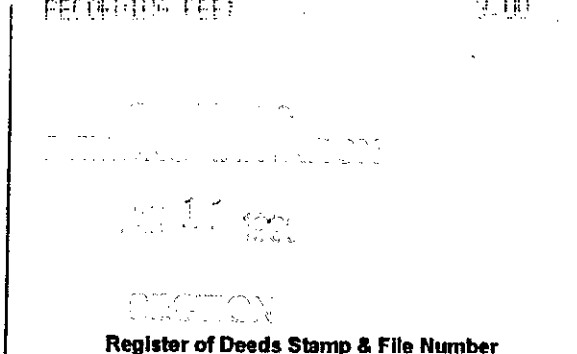

	A	B	C	D	E	F	G	H	I	J	K	L	M
1													
2	6	5	4	3	2	1							
3													
4	7	8	9	10	11	12							
5													
6	18	17	16	15	14	13							
7													
8	19	20	21	22	23	24							
9													
10	30	29	28	27	26	25							
11													
12	31	32	33	34	35	36							
13													

I, Joseph C. Domitrovich, in a field survey on August 18, 1998, do hereby state that under requirements of P.A. 74, Michigan P.A. of 1970, the corner points mentioned in lines 1 and 2 above were in conformance with regulations and rules therefore as required in the current manual of survey instructions of the United States Department of the Interior, Bureau of Land Management or by a decree of a Court of Law and /or that the corner points mentioned in lines 3, 4 and 5 above were in conformance with the rules of the Michigan Board of Land Surveyors or by a Decree of a Court of Law; established, re-established, monumented, recovered, found as expressed below:

NOTE: Not more than 2 corners, all in the same town and range, may be recorded on this certificate.

A. Description of original monument and accessories and/or subsequent restoration:

(L-11) 1/4 Corner Common to Sections 25 & 36, T51N,R38W

1846 - Sylvester W. and Hiram Higgins set post.  
 12" Sugar N 75° E 16 links  
 12" Hemlock S 80° W 21 links

circa

1950-1960 - Michigan State Highway Department, (M.S.H.D.) found a 1" drill steel at this corner. They tied the corner into highway centerline control and gave bearings and distances from it to Section Corners to the East and West.

PLER GROUP APPROVED  
*Earl W. Applekamp*  
 COUNTY REGISTERED 8-19-98

B. Description of corner evidence found and/or method applied in restoring or reestablishing corner:

I found no remains of the original corner or accessories. The corner has been destroyed by the County road and highway construction. I did not recover the drill steel called for by M.S.H.D. I recreated the position of it from prorated M.S.H.D. bearings and distances from Section Corners to the East and West. This position works well with highway centerline control. It also works well with old county road running to the East and abandoned old road bed to North. The distance to the Section Corner to the East is quite long. I believe this is the result of either gross error or fraudulent work on the part of the original surveyors. I have accepted the M.S.H.D. position and have monumented it as such.


Research on file with County Remonumentation Representative.

C. Description of monument for corner and accessories established to perpetuate locating the position of the corner:

Corner is a 2 1/2" x 30" aluminum pipe with a 3" diameter aluminum cap stamped to read: COUNTY REMONUMENTATION; S.25, S.36; 1/4; T.51N, R.38W; 1998; P.S. 37273. The Corner falls on the Southerly edge of Southerly gravel shoulder of Highway M-26, 24.5 feet South of centerline.

Witnesses:

6" Elm	S 58° E	94.67'	
N'y leg of "Baraga-Houghton" sign	S 28° E	8.31'	
Steel Sign Post	South	7.77'	
M-26/M-38 Sign	S 86° W	137.75'	
S'y leg of "Adopt-a-Highway" sign	N 60° W	142.36'	
NW Cor. Section 36	N 89°26'07" W	2628.41'	(2628.56' M.S.H.D.; 2640.66' GLO)
NE Cor. Section 36	S 89°25'34" E	2740.14'	(2740.28' M.S.H.D.; 2640.66' GLO)

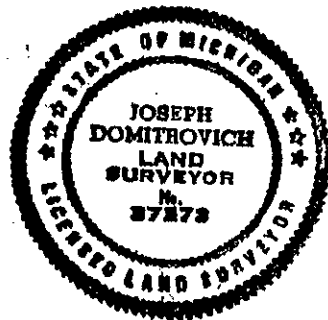

NOTE: Bearings to witness objects are magnetic. Distances are to a nail in side of the witness object unless noted.

Signed by Joseph C. Domitrovich

Date 8-19-98

Surveyor's Michigan License No. 37273