

LAND CORNER RECORDATION CERTIFICATE of 2
 Filing Requirement of Act 74, Mich. P.A. 1970
 Date 11/23/1999 Time 18:38:27
 RECORDING FEE: 11.00

For corners in

Ontonagon County	Located in:	Corner Code #
1. Public Land Survey	T51N R40W	M-5
	T51N R39W	A-5
	T R	
	T R	
2. Property Controlling in Section	S T R	
	S T R	
3. Miscellaneous Property in Sec.	S T R	
	S T R	
4. Lot No.	Recorded Plat	
5. Private Claims		

SURVEY & REMONUMENTATION

MAR 23 2000

SECTION

Register of Deeds Stamp & File Number

	A	B	C	D	E	F	G	H	I	J	K	L	M
1													
2	6		5		4		3		2		1		
3													
4	7		8		9		10		11		12		
5													
6	18		17		16		15		14		13		
7													
8	19		20		21		22		23		24		
9													
10	30		29		28		27		26		25		
11													
12	31		32		33		34		35		36		
13													

I, Joseph C. Domitrovich, in a field survey on November 1, 1999, do hereby state that under requirements of P.A. 74, Michigan P.A. of 1970, the corner points mentioned in lines 1 and 2 above were in conformance with regulations and rules therefore as required in the current manual of survey instructions of the United States Department of the Interior, Bureau of Land Management or by a decree of a Court of Law and for that the corner points mentioned in lines 3, 4 and 5 above were in conformance with the rules of the Michigan Board of Land Surveyors or by a Decree of a Court of Law; established, re-established, monumented, recovered, found as expressed below:

NOTE: Not more than 2 corners, all in the same town and range, may be recorded on this certificate.

A. Description of original monument and accessories and/or subsequent restoration:

(M-5 & A-5) Corner Common to Section 12 & 13, T51N, R40W and 7 & 18, T51N, R39W.

1845 Austin Burt set a post for the Section Corner on the right bank of the Ontonagon River with Ties:

10" Sugar S54°E 19 links
 12" Sugar N 11°W 30 links

No Record of Susequent Restoration.

B. Description of corner evidence found and/or method applied in restoring or reestablishing corner:

I found no remains of the original corner or accessories. Corner has been destroyed by river erosion. The Ontonagon River has dramatically changed course since 1845. The section corner now falls on the left bank of the Ontonagon River. (SEE SKETCH ON BACK) I re-established the corner position by single proportionate measurement between the 1/4 Corner 1/2 mile to the North and the Section Corner 1 mile to the South.


Research on file with County Remonumentation Representative.

BEER GROUP APPROVED
Carl W. Applebaum
 COUNTY / SUPERVISOR

C. Description of monument for corner and accessories established to perpetuate locating the position of the corner:

Corner is a 3/4" x 11' long aluminum rod with a 3" diameter aluminum cap stamped to read: County Remonumentation; T51N, R40W, R39W; S. 12, S. 13, S. 7, S. 18; 1999; P.S. 37273. Corner falls in a sandy brush-covered area 16' north and 20' west of the top left bank of the Ontonagon River. Ties:

3" Elm	S 75°W	57.52'
Steel Sign Rail	N 63°W	5.70' (to face)
Steel Sign Rail	N 36°E	6.43' (to face)
Meander Corner on Right Bank	S 00°33'27"E	399.16'
E 1/4 Corner Section 12	N 00°33'27"W	2661.16'
SE Corner Section 13	S 00°33'27"E	5322.33'
M.C. Sections 12 & 13	N 89°39'45"W	350.03' (previous left bank of river)
(No other ties available)		

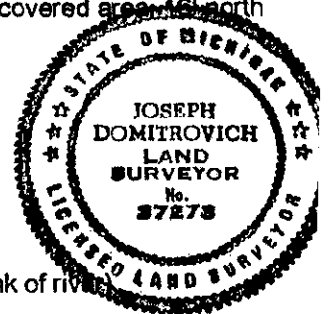

NOTE: Bearings to witness objects are magnetic. Distances are to a nail in side of the witness object unless noted.

Signed by *Joseph C. Domitrovich*

Date 11/09/99

Surveyor's Michigan License No. 37273