

LAND CORNER RECORDATION CERTIFICATE of 1
Filing Requirement of Act 74, Mich. P.A. 1970

For corners in

Ontonagon County	Located in:	Corner Code #
1. Public Land Survey	T51N R39W	B - 5
	T R	
	T R	
	T R	
2. Property Controlling in Section	S T R	
	S T R	
3. Miscellaneous Property in Sec.	S T R	
	S T R	
4. Lot No. , Recorded Plat		
5. Private Claims		

SURVEY & REMONUMENTATION

MAR 23 2000

SECTION

Register of Deeds Stamp & File Number

	A	B	C	D	E	F	G	H	I	J	K	L	M
1													
2	6		5		4		3		2		1		
3													
4	7		8		9		10		11		12		
5	●												
6	18		17		16		15		14		13		
7													
8	19		20		21		22		23		24		
9													
10	30		29		28		27		26		25		
11													
12	31		32		33		34		35		36		
13													

I, Joseph C. Domitrovich, in a field survey on December 7, 1999, do hereby state that under requirements of P.A. 74, Michigan P.A. of 1970, the corner points mentioned in lines 1 and 2 above were in conformance with regulations and rules therefore as required in the current manual of survey instructions of the United States Department of the Interior, Bureau of Land Management or by a decree of a Court of Law and for that the corner points mentioned in lines 3, 4 and 5 above were in conformance with the rules of the Michigan Board of Land Surveyors or by a Decree of a Court of Law; established, re-established, monumented, recovered, found as expressed below:

NOTE: Not more than 2 corners, all in the same town and range, may be recorded on this certificate.

A. Description of original monument and accessories and/or subsequent restoration:

(B - 5) 1/4 Corner Common to Sections 7 & 18, T51N, R39W

1845 Austin Burt set an ironwood post with ties:

- 12" Hemlock S 39°E 40 links
- 8" Hemlock N 24°W 31 links

I found no record of subsequent restoration.

B. Description of corner evidence found and/or method applied in restoring or reestablishing corner:

I found no remains of the original corner or accessories. I re-established a position for the 1/4 corner by single proportionate measurement. This position falls on the approximate extension of a blazed line to the West and +/- 10' West of a blazed line to the North. I believe the single proportionate position best represents the original location of the GLO 1/4 corner. I placed a county monument at this position.

Research on file with County Remonumentation Representative.

DEER GROUP APPROVED
Carl W. Applekamp 12/20/99
COUNTY REGISTER OF DEEDS

C. Description of monument for corner and accessories established to perpetuate locating the position of the corner:


Corner is a 2 1/2" x 30" aluminum pipe with a 3" diameter aluminum cap stamped to read: COUNTY REMONUMENTATION; T51N, R39W; 1/4; S.7, S.18; 1999; P.S. 37273. Corner falls on the Easterly Edge of a 4-wheeler trail. Ties:

- 6" Hard Maple N 05°E 25.70'
- 6" Hard Maple N 87°E 19.88' (Existing Blaze)
- 10" Soft Maple S 07°E 29.08'
- Steel Sign Rail South 0.61' (to face)
- 8" Ash S 80°W 18.55'
- SW Corner Section 8 S 89°51'29"W 2768.38' (meas.) 2780.58' (GLO)
- SE Corner Section 8 N 89°51'29"E 2628.41' (meas.) 2640.00' (GLO)

NOTE: Bearings to witness objects are magnetic. Distances are to a nail in side of the witness object unless noted.

Signed by *Joseph C. Domitrovich*

Date 12/14/99

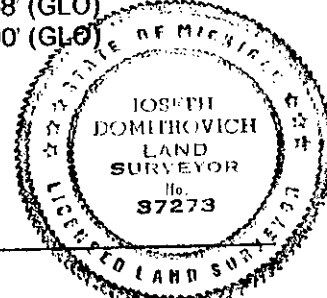

Surveyor's Michigan License No. 37273