

JUDITH D. ROEHM

1P

LAND CORNER RECORDATION CERTIFICATE
Filing Requirement of Act 74, Mich. P.A. 1970

Ontonagon County
Page 1 of 1
JEM Date 11/23/1999 Time 18:40:28
RECORDING FEE: 9.00

For corners in

Ontonagon County	Located in:	Corner Code #
1. Public Land Survey	T51N R39W	B - 7
	T R	
	T R	
	T R	
2. Property Controlling in Section	S T R	
	S T R	
3. Miscellaneous Property in Sec.	S T R	
	S T R	
4. Lot No.	Recorded Plat	
5. Private Claims		

SURVEY & REMONUMENTATION

MAR 23 2000

SECTION

Register of Deeds Stamp & File Number

	A	B	C	D	E	F	G	H	I	J	K	L	M
1													
2	6	5	4	3	2	1							
3													
4	7	8	9	10	11	12							
5													
6	18	17	16	15	14	13							
7	●												
8	19	20	21	22	23	24							
9													
10	30	29	28	27	26	25							
11													
12	31	32	33	34	35	36							
13													

I, Joseph C. Domitrovich, in a field survey on November 3, 1999, do hereby state that under requirements of P.A. 74, Michigan P.A. of 1970, the corner points mentioned in lines 1 and 2 above were in conformance with regulations and rules therefore as required in the current manual of survey instructions of the United States Department of the Interior, Bureau of Land Management or by a decree of a Court of Law and /or that the corner points mentioned in lines 3, 4 and 5 above were in conformance with the rules of the Michigan Board of Land Surveyors or by a Decree of a Court of Law; established, re-established, monumented, recovered, found as expressed below:

NOTE: Not more than 2 corners, all in the same town and range, may be recorded on this certificate.

A. Description of original monument and accessories and/or subsequent restoration:

(B - 7) ¼ Corner Common to Sections 18 & 19, T51N, R39W.

1845 Austin Burt set a maple post on the left bank of the Ontonagon River with ties:

10" Cedar	S 21°E	18 links
6" Birch	N 83°W	55 links

No Record of Susequent Restoration.

B. Description of corner evidence found and/or method applied in restoring or reestablishing corner:

I found no remains of the original corner or accessories. The old River Road which traveled along the left bank of the Ontonagon River would have destroyed the Corner and Bearing Trees. I re-established the corner position by single proportionate Measurement between Section Corners east and west.

Research on file with County Remonumentation Representative.

PEER GROUP APPROVED


Earl W. Applekamp

COUNTY 8725 LKCAJ.4778

C. Description of monument for corner and accessories established to perpetuate locating the position of the corner: 11-09-99

The Corner is a 2 ½" x 30" diameter aluminum monument with a 3" diameter aluminum cap stamped to read: County Remonumentation; T51N, R39W; ¼; S. 18, S. 19; 1999; P.S. 37273. The corner falls 5' South and 18' West of the top of bank of the Ontonagon River. I also set a ½" x 24" iron pin with a 2" diameter aluminum cap stamped to indicate that the ¼ corner is N 89°20'E, 42.27'. Ties to the ¼ Corner:

19" Basswood	S 05°E	16.38'
Steel Sign Rail	South	1' (to face)
12" Hard Maple	S 13°W	48.58'
16" Hard Maple	S 62°W	56.36'
½" iron w/ stamped cap	S 89°20'16"W	42.27'
SW Corner Section 18	S 89°20'16"W	2723.41'
SE Corner Section 18	N 89°20'16"E	2629.41'
M.C. on Right Bank	N 89°20'16"E	797.69'

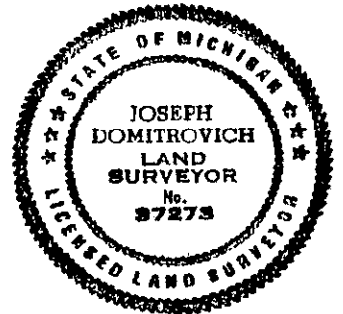

NOTE: Bearings to witness objects are magnetic. Distances are to a nail in side of the witness object unless noted.

Signed by *J. C. Domitrovich*

Date 10/09/99

Surveyor's Michigan License No. 37273