

SURVEY & REMONUMENTATION

APR 29 1996

COMMISSION

JUDITH D. ROEHM
 Ontonagon County
 LC 4/ 10 JEM Fee: 9.00
 Page 1 of 1

LAND CORNER RECORDATION CERTIFICATE
 Filing Requirement of Act 74, Mich. P.A. 1970

For corners in

<u>ONTONAGON</u> (County)	Located In:	Corner Code#
1. Public Land Survey	T <u>51</u> R <u>39</u>	<u>C-1</u>
	T ___ R ___	_____
	T ___ R ___	_____
	T ___ R ___	_____
2. Property Controlling in Section	S ___ T ___ R ___	_____
	S ___ T ___ R ___	_____
3. Miscellaneous Property in Sec.	S ___ T ___ R ___	_____
	S ___ T ___ R ___	_____

Register of Deeds Stamp & File Number

4. Lot No. _____, Recorded Plat _____
 5. Private Claims _____

Closing Section Corner common to Sections 5 & 6, T51N R39W.

I, Earl W. Applekamp, in a field survey on August 19, 1995 do hereby state that under requirements of P.A. 74, Michigan P.A. of 1970, the corner points mentioned in lines 1 and 2 above were in conformance with regulations and rules therefore as required in the current manual of survey instructions of the United States Department of the Interior, Bureau of Land Management or by a decree of a Court of Law and /or that the corner points mentioned in lines 3, 4 and 5 above were in conformance with the rules of the Michigan Board of Land Surveyors or by a Decree of a Court of Law; established, re-established, monumented, recovered, found as expressed below:

NOTE: Not more than 2 corners, all in the same town and range, may be recorded on this certificate.

	A	B	C	D	E	F	G	H	I	J	K	L	M
1													
2	6		5		4		3		2		1		
3													
4	7		8		9		10		11		12		
5													
6	18		17		16		15		14		13		
7													
8	19		20		21		22		23		24		
9													
10	30		29		28		27		26		25		
11													
12	31		32		33		34		35		36		
13													

A. Description of original monument and accessories and/or subsequent restoration:

Original corner established by Austin Burt, U.S. Deputy Surveyor. Set Hemlock Post, August 1845.

ORIGINAL BEARING TREES:


Birch 24" S66°W 64 links (42.24 feet)
 Birch 24" S15°E 16 links (10.56 feet)

B. Description of corner evidence found and/or method applied in restoring or reestablishing corner:

No original evidence was found. At the corner position I found a 1/2" rebar in the centerline of a blacktop road, which had been used for surveys in the area. There are double corners on this township line. This location is in agreement with the GLO calls for land to the South. The distances found between corners West and South are in agreement with the original survey distances.

Research on file.

PEER GROUP APPROVED
Earl W. Applekamp 12-14-95
 COUNTY REPRESENTATIVE

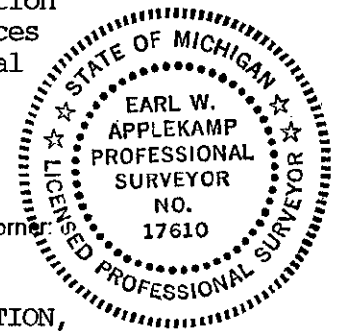

C. Description of monument for corner and accessories established to perpetuate locating the position of the corner:

At the corner position I set a 3/4"x15" aluminum rod with a 3 1/2" cap, 2" below top of blacktop. Cap is stamped to read: COUNTY REMONUMENTATION, T51N R39W, S.5, S.6, 1995, P.S. 17610. I established the following bearing trees and reference objects:

8" Oak N84°W 36.34 feet - Power Pole N24°E 87.87 feet
 7" White Pine S63°E 41.89 feet - 2 1/2"x30" aluminum reference monument with cap, East 32.80 feet

Signed by *Earl W. Applekamp*
 Surveyor's Michigan License No. 17610

Date December 2, 1995