

LAND CORNER RECORDATION CERTIFICATE
Filing Requirement of Act 74, Mich. P.A. 1970
Ontonagon County Remonumentation Corner

Ontonagon County

of 1

LC

5/207

REC'D Date 07/27/99 Time 14:56
RECORDING FEE: 9.00

For corners in

Table with 3 columns: Ontonagon County, Located in:, Corner Code #. Includes entries for Public Land Survey, Property Controlling in Section, Miscellaneous Property in Sec., Lot No., and Private Claims.

SURVEY & REMONUMENTATION

MAR 23 2000

SECTION

Register of Deeds Stamp & File Number

Grid table with columns A-M and rows 1-13. A dot is marked at the intersection of column C and row 4.

I, Joseph C. Domitrovich, in a field survey on July 16, 1999, do hereby state that under requirements of P.A. 74, Michigan P.A. of 1970, the corner points mentioned in lines 1 and 2 above were in conformance with regulations and rules therefore as required in the current manual of survey instructions of the United States Department of the Interior, Bureau of Land Management or by a decree of a Court of Law and/or that the corner points mentioned in lines 3, 4 and 5 above were in conformance with the rules of the Michigan Board of Land Surveyors or by a Decree of a Court of Law; established, re-established, monumented, recovered, found as expressed below:

NOTE: Not more than 2 corners, all in the same town and range, may be recorded on this certificate.

A. Description of original monument and accessories and/or subsequent restoration:

(C-4) 1/4 Corner Common to Sections 7 & 8, T51N, R39W

- 1845 - Austin Burt set a black ash Post.
8" Black Ash S30°E 20 links
16" Spruce N32°W 19 links

1949 - Michigan State Highway Department shows stations for corner on their US-45 Highway plans but do not indicate what corner is.

1988 - Robert Mick, P.S. 16936, recorded this corner. He found a 1" iron pipe 4" below water in ditch. He has no ties to the corner but shows the corner being due West of station 120+55 and due South of Station 122+00. (As per Highway plans)

1988 - Robert Mick, P.S. 16936 shows this corner on a survey recorded in Liber 1, Page 105 of Survey Records.

B. Description of corner evidence found and/or method applied in restoring or reestablishing corner:

I found no remains of the original corner of accessories. Corner now falls in the westerly ditch of US-45. I recovered a 1/2" iron pin with cap No. 16936 driven at the base of a bent 1" iron pipe as called for by Robert Mick. This position agrees with distance south to 1/16 and section corners he shows on his recorded survey. It also works well with other corners in the area. I accepted it as the 1/4 corner and replaced the 1/2" iron pin with a 5/8" iron pin and Aluminum Cap.


Research on file with County Remonumentation Representative.

PEER GROUP APPROVED
Carl W. Gulikamp 7-20-99
COUNTY REPRESENTATIVE

C. Description of monument for corner and accessories established to perpetuate locating the position of the corner:

Corner is a 5/8" iron pin with a 3" diameter Aluminum Cap stamped to read: COUNTY REMONUMENTATION; T51N, R39W; 1/4; S.7, S.8; 1999; P.S. 37273. Ties:

Table with 3 columns: Witness object, Bearing, Distance. Includes items like 18" Twin Spruce, Steel Sign Rail, 9" Spruce, 18" Twin Spruce, SW Corner Sec. 8, NW Corner Sec. 8.

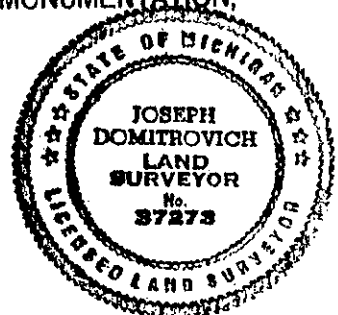

NOTE: Bearings to witness objects are magnetic. Distances are to a nail in side of the witness object unless noted.

Signed by [Signature]

Date 7/26/99

Surveyor's Michigan License No. 37273